


Form 51-5M-7-39-Palace

Ellis

Section 28 Township 12 Range 16-W

Well No. #1 Witt

Company Stearns Drilling

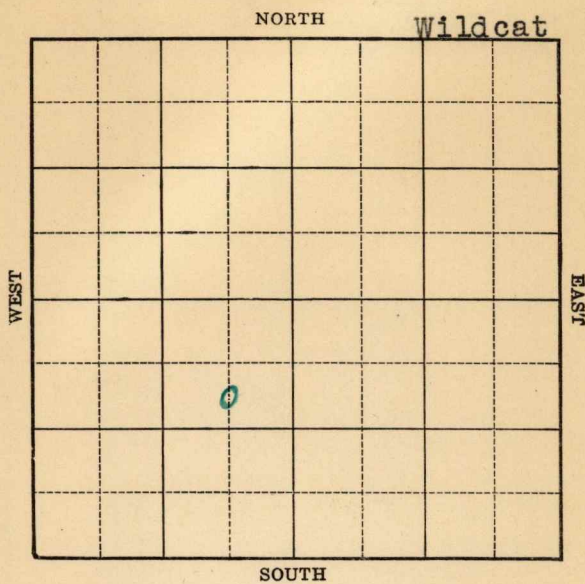

Sec. 28 Twp. 12 R. 16-WWell No. #1 Witt Farm _____Stearns Drilling Company

(Wildcat)


990 Ft. from N. Line

Ft. from S. Line

660 Ft. from E. Line

Ft. from W. Line

Elev. 2115

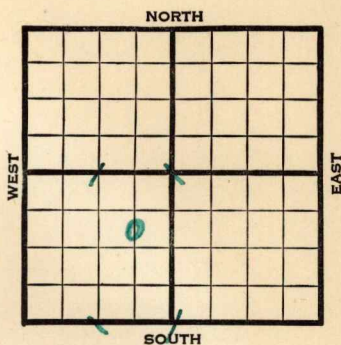

1940

REPORT

10/9 Cable.

10/17 "

10/24 "

10/31 Drlg. 500'

11/7 15" - 592'

Drlg. 925'

11/14 13" - 930'

Drlg. 1330'

11/21 10" - 1368' Anhy 1238'

Drlg. 2035'

11/27 Drlg. 2500'

12/5 8" - 2535' 2830' UR 8".

12/12 8" - 2817' Drlg. 2868'

12/19 Drlg. 2970'

12/26 6" - 3040' Drlg. 3160'

1941

1/2 Drlg. 3400'

1/9 Lans. 3342' 7" - 3452'

Drlg. 3560'

OVER

1941

1/16

B.K.C. 3545' Arb. 3609'

T.D. 3626' Show dead oil.

Shut down.

1/23

" "

1/30

" "

2/6

P.B. to Lansing.

2/12

Lans. 3342'

B.K.C. 3545'

Arb. 3609'

T.D. 3626'

7" - 3452'

P.B. to 3527'

8000 acid.

Potential 647 bbls. plus 25%
water on pump.

36.4 Gravity

COMPLETED

Map No. 71 Sec. 28 Twp. 12 R. 16WWell No. 1 WittStearns Drilling Company

Contractor


FIRST REPORT

C S L NE SW

990 Ft. from N. Line Ft. from S. Line660 Ft. from E. Line Ft. from W. Line

WILDCAT

SECTION PLAT

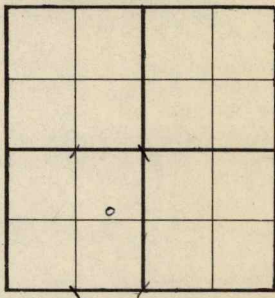Location Rig up

Drilling and Remarks:

Cable

RECORD

Cased in., ft.Sand Gas Oil Total Depth

PRODUCTION

1st 24 hrs. Nat. 1st 24 hrs. after shot Gas Cu. Ft.Dry Hole Abandoned

Date

OCT 9 1940 19S. J. LEWIS Scout

Map No. 71 Sec. 28 Twp. 12 R. 16WWell No. 1 WittStearns Drilling Company

Contractor

COMPLETED

C S L N E S W

990 Ft. from N. Line

_____ Ft. from S. Line

660 Ft. from E. Line

_____ Ft. from W. Line

WILDCAT

SECTION PLAT

Location _____

Rig up _____

Drilling and Remarks:

*Lions 3342.**BHC 3545.**Cr 83609.**PB 3537.**7" CB 402.**5000 acid**Pump 647 P 8725**364 Gr.*

RECORD

Cased _____ in., _____ ft.

Sand _____

Gas _____

Oil _____

Total Depth 3626

PRODUCTION

1st 24 hrs. Nat. _____

1st 24 hrs. after shot _____

Gas _____ Cu. Ft.

Dry Hole _____

Abandoned _____

2 Waters

Date

FEB 12 1941 19

S. J. LEWIS

Scout