


Section 28 Township 12 Range 16W

Well No. #1 Klotz

Company Dan Ingling

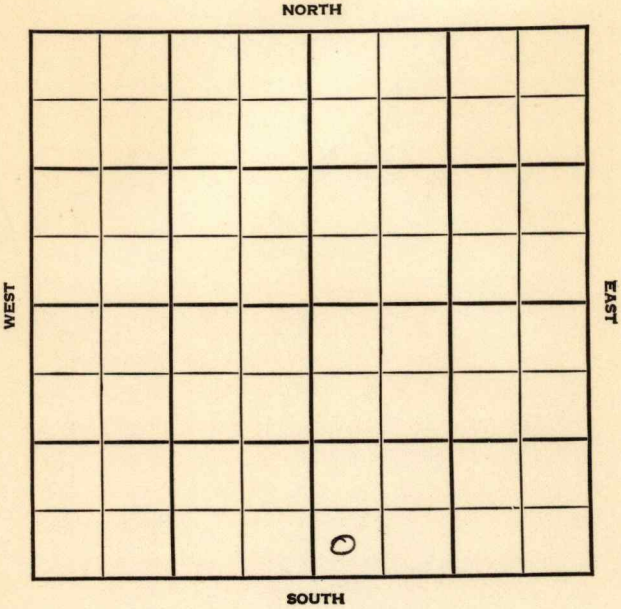



Sec. 28 Twp. 12 R. 16W

Well No. #1 Klotz Farm

Don Ingling Company

Wildcat


Ft. from N. Line

330 Ft. from S. Line

Ft. from E. Line

330 Ft. from W. Line

SW SE

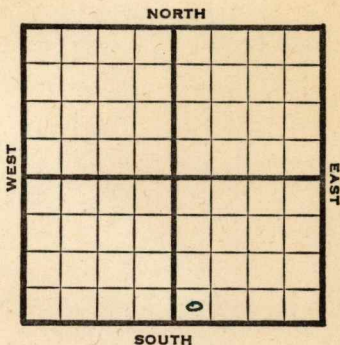

1947

Elev. 2099' REPORT

12/30

10" @ 105'

Drlg. 850'

1948

1/7

Drlg. 2700'

1/14

Lansing 3320'

Drlg 3410'

1/21

Arb. 3578'

TD 3610'

Abd.

ABANDONED

Map No. \_\_\_\_\_ Sec. 28 Twp. 12 R. 16W

Well No. 1 Klotz

Don Ingling Company

FIRST REPORT Contractor

SW SE

SECTION PLAT

\_\_\_\_\_ Ft. from N. Line

330 Ft. from S. Line

\_\_\_\_\_ Ft. from E. Line

330 Ft. from W. Line


Ellis County

RECORD

Location \_\_\_\_\_

Cased \_\_\_\_\_ in., \_\_\_\_\_ ft.

Rig up \_\_\_\_\_

Sand \_\_\_\_\_

Drilling and Remarks:

Gas \_\_\_\_\_

10" @105

Oil \_\_\_\_\_

drlg. 850

Total Depth \_\_\_\_\_

PRODUCTION

1st 24 hrs. Nat. \_\_\_\_\_

1st 24 hrs. after shot \_\_\_\_\_

Gas \_\_\_\_\_ Cu. Ft.

Dry Hole \_\_\_\_\_

Abandoned \_\_\_\_\_

Date

DEC 30 1947

19

S. J. LEWIS

Scout

