


Section 28 Township 12 Range 16 W

Well No. #1 Klotz

Company Wentworth Drlg.

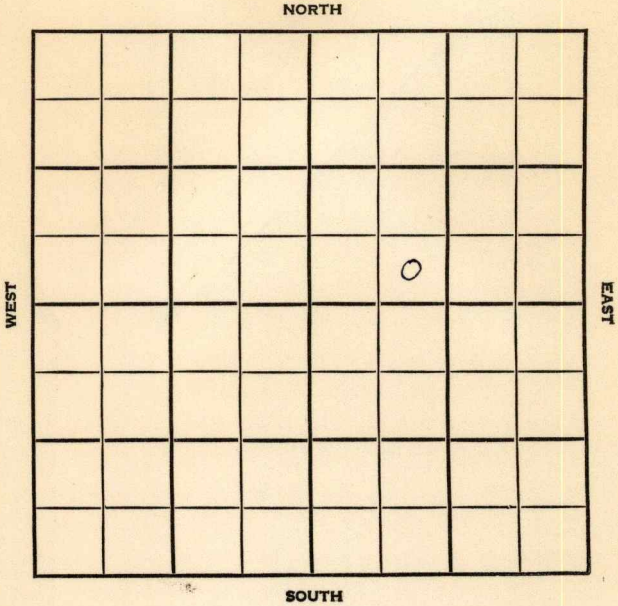

Ellis

KANSAS

SEC. 28	TWP. 12	R. 16W
------------	------------	-----------

WELL NO.

#1 Klotz
COMPANY

FARM

Wentworth
CONTRACTOR

Co. Tools

Wildcat


_____ Ft. from N. Line

_____ Ft. from S. Line

_____ Ft. from E. Line

_____ Ft. from W. Line

SE SW NE

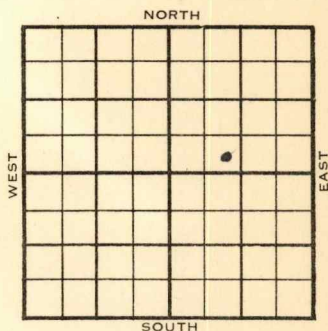

1955	ELEVATION 2114	REPORT FIRST REPORT
------	-------------------	------------------------

8/10

Comm 8/5/55

8-24

8 5/8" @ 229/

DST 3336-85 open 1 hr., rec. 75' GIP
15' oil spkd mud 900' o&sgcw 870#

DST 3402-23 open 40 min. rec. 30' oil
spkd mud 60#

DST 3422-32 open 1/2 hr. Rec. 7' so spkd
mud 950#

DST 3568-3604 open ? rec. 5' mud 0#
D & A

H. 3283, 1169, Dg. 3303 1189, L. 3335,
1221, A 3594, 1480, T.D. 3647

ABANDONED

County Ellis Elev. 2114
 Sec. 28 Twp. 12 Rge. 16W
 Company Wentworth Drlg.
 Farm Name Klotz No. 1

TOPS	DEPTH	LOG	DATUM
Anh.			
Tp.			
H.			
Tr.			
Dg.			
Bl.			
L.			
K.C.			
B.K.C.			
Ce.			
C.			
M.			
M.			
K.			
Mz.			
Ma.			
V.			
S.			
S.			
A.			
R.			
Pf.			
G.			
T.D.			

Loc. in Sec. SE SW NE

Geol. _____

Contr. _____

Co. tools

Pool _____

Wildcat

AUG 10 '55	
FIRST REPORT	

Date Comm. 8-5-55

Co.

Lse.

No.

Sec.

T.

R.

County Ellis Elev. 2114
 Sec. 28 Twp. 12 Rge. 16W
 Company Wentworth Drlg.
 Farm Name Klotz No. 1

TOPS	DEPTH	LOG	DATUM	Loc. in Sec.
Anh.				SE SW NE
TP.				
H.	3283		1169	
Tr.				
Dg.	3303		1189	
BL.				
L.	3335		1221	
K.C.				Geol.
B.K.C.				Contr.
Ce.				Co. tools
C.				
M.				Pool
M.				
K.				Wildcat
Mz.				
Mq.				
V.				
S.				
S.				
A.	3594		1480	
R.				
PE.				
G.				
T.D.	3647			



Date Comm. 8-5-55 AUG 24 1955

8 5/8" @ 229/ DST 3336-85 open 1 hr.
Rec. 75' GIP 15' oil spkd mud 900'
o & sgw 870# DST 3402-23 open 40 min.
Rec. 30' oil spkd mud 60# DST 3422-32
open 1/2 hr. Rec. 7' so spkd mud 950#
DST 3568-3604 open ? Rec. 5' mud 0#
D & A

Co.
Lse.
No.
Sec.
T.
R.