


Ellis

KANSAS

SECTION 28 TOWNSHIP 12 RANGE 16 W

WELL NO. #2 Klotz

COMPANY Wentworth & Sons

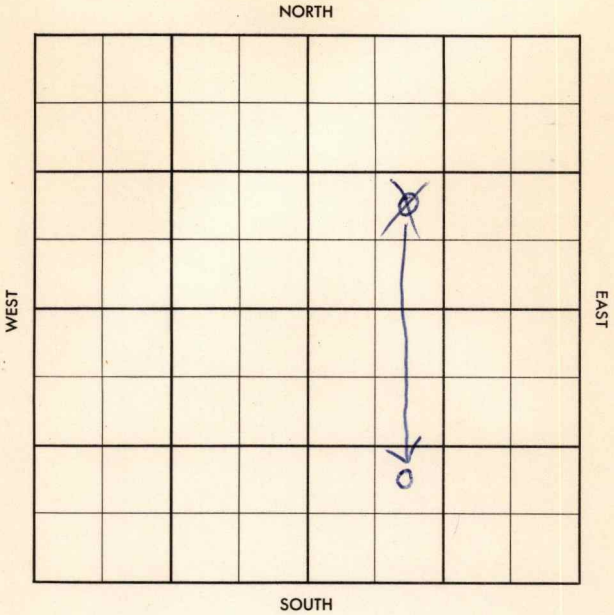

KANSAS

TWP.

R.

28

12

16W

WELL NO.

#2 Klotz

FARM

COMPANY

Wentworth & Sons

CONTRACTOR

Ft. from N. Line

990


Ft. from S. Line

Ft. from E. Line

990

Ft. from W. Line

NE SW ~~NE~~
SE

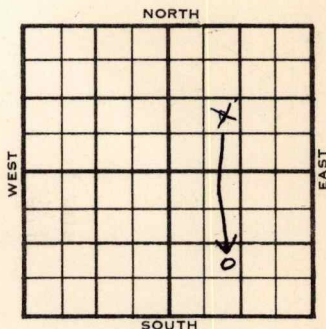

1955

ELEVATION

1843

REPORT

11-30

Comm. 11-22-55

DST 3256-86 op 1 hr. rec. 45' mud, 930#
Drlg. 3445'

12-7


[illegible][illegible]


#

[illegible]

#####

Tr. ~~###~~ 3036!

H. ~~####~~ 3305

~~#####~~ Dodge 3325

~~#####~~ L. 3356

~~陈其南陈其南~~ C. 3594

TD 3692'

8 5/8" @ 225/130

DST 3401-55 op 1 hr. rec. 65' mud,
950/20"

D & A

ABANDONED

County

~~Ellis~~

Elev.

Sec.

~~28~~

Twp.

~~12~~

Rge.

~~16W~~

Company

~~Wentworth & Sons~~

Farm Name

~~Klotz~~

No.

~~2~~

TOPS

DEPTH

LOG

DATUM

Loc. in Sec.

Anh.

Tp.

H.

Tr.

Dg.

B.L.

L.

K.C.

B.K.C.

Ce.

C.

M.

M.

K.

Mz.

Mq.

V.

S.

S.

A.

R.

P.C.

G.

T.D.

~~NE SW NE~~

Geol.

Contr.

Pool

NOV 30 '55

0

FIRST REPORT

Date Comm. 11-22-55

DST 3256-86 open 1 hr. rec. 45' mud

930# drlg. 3445

SCOUT TICKET

DX-201

SEC.

28

TWP.

12

R.

16W

WELL NO.

2 Klotz

FARM

COMPANY

Wentworth & Sons

CONTRACTOR

NE SW SE

____ FT. FROM N. LINE


990

____ FT. FROM S. LINE

____ FT. FORM E. LINE

990

____ FT. FROM W. LINE

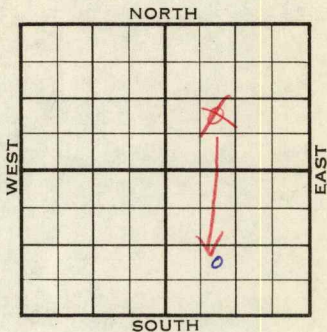

Ellis County

☐

LOCATION

☐

RIG UP

DRILLING AND REMARKS:

Reported
NE SW NE

RECORD

CASED IN., FT.

SAND

GAS

OIL

TOTAL DEPTH

PRODUCTION

1ST 24 HRS. NAT.

1ST 24 HRS. AFTER SHOT

GAS

CU. FT.

DRY HOLE

ABANDONED

DATE

SCOUT

County Ellis Elev. 2120
 Sec. 28 Twp. 12 Rge. 16W
 Company Wentworth & Sons
 Farm Name Klotz No. 2

TOPS	DEPTH	LOG	DATUM	Loc. in Sec.
Anh.				NE SW SE
TP.	<u>3036</u>		<u>916</u>	
H.	<u>3305</u>		<u>1185</u>	
Tr.				
Dg. <u>Dodge</u>	<u>3325</u>		<u>1205</u>	
BL.				
L.	<u>3356</u>		<u>1236</u>	Geol.
K.C.				Contr.
B.K.C.				
Ce.				
C.	<u>3594</u>		<u>1474</u>	
M.				Pool
M.				
K.				
Mz.				
Mq.				
V.				
S.				
S.				
A.				
R.				
Pe.				
G.				
TD.	<u>3692</u>			

Date Comm. 11-22-55

DEC 7 1955

DST 3356-86 open 1 hr. rec. 45' mud

930# 8 5/8" @ 225/130 DST 3401-55

open 1 hr. rec. 65' mud 950/20"

D & A