


Section 4 Township 17 Range 11W

Well No. #5 Riemann

Company Magnolia

Kraft Prusa Pool NORTH

//

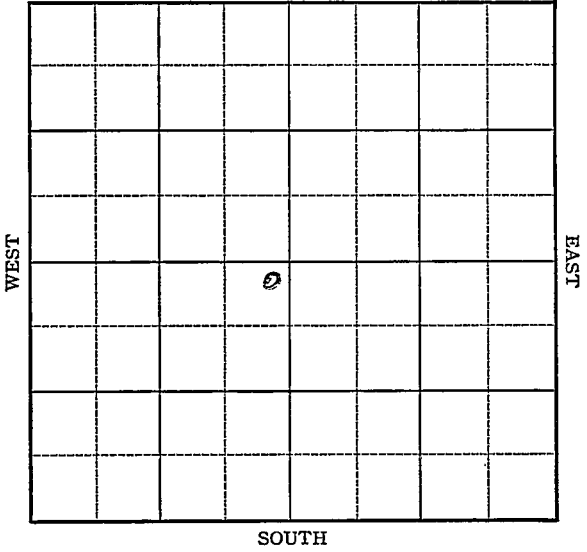

Sec. 4 Twp. 17 R. 11W

Well No. 5 Riemann Farm

Magnolia Company

(Kraft Prusa Pool)


330 Ft. from N. Line

\_\_\_\_\_ Ft. from S. Line

330 Ft. from E. Line

\_\_\_\_\_ Ft. from W. Line

*Elev. 1861*

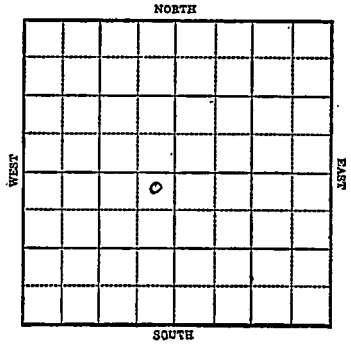

1942

R E P O R T

10/28 10<sup>1</sup>/<sub>4</sub> - 279 WOO.  
 11/4 Drlg. 2460  
 11/11 Arb. 3299  
 TD 3301  
 7" @ 3301 RUST

11/18 Arb. 3299  
 7" @ 3301  
 T.D. 3311'  
 1000 Acid  
 Pump 400 Pot.  
 Gravity 43.6

**COMPLETED**

Map No. 55 Sec. 4 Twp. 17 R. 11WWell No. 5 RiemannMagnolia CompanyFIRST REPORT Contractor

NE SW

## SECTION PLAT

330 Ft. from N. Line

	o		

\_\_\_\_\_ Ft. from S. Line

330 Ft. from E. Line

\_\_\_\_\_ Ft. from W. Line

KRAFT PRUSA POOL

Location \_\_\_\_\_

## RECORD

Cased \_\_\_\_\_ in., \_\_\_\_\_ ft.

Sand \_\_\_\_\_

Gas \_\_\_\_\_

Oil \_\_\_\_\_

Total Depth \_\_\_\_\_

Rig up \_\_\_\_\_

Drilling and Remarks:

10" - 279 WOG

## PRODUCTION

1st 24 hrs. Nat. \_\_\_\_\_

1st 24 hrs. after shot \_\_\_\_\_

Gas \_\_\_\_\_ Cu. Ft.

Dry Hole \_\_\_\_\_

Abandoned \_\_\_\_\_

Date

OCT 28 1942 19S. J. LEWIS Scout

Form 26, 200 Bks 5-42 Petrol  
**KANSAS** Barton

Map No. 55 Sec. 4 Twp. 17 R. 11W

Well No. 5 Riemann

Magnolia Company

**COMPLETED** Contractor

NE SW

SECTION PLAT

330 Ft. from N. Line

\_\_\_\_\_ Ft. from S. Line

330 Ft. from E. Line

\_\_\_\_\_ Ft. from W. Line

	o		

**KRAFT PRUSA POOL**

Location \_\_\_\_\_

Rig up \_\_\_\_\_

Drilling and Remarks:

*Ac 83299*  
*7" @ 330'*  
*1000 acid*  
*Pump 400 ft*  
*43 6/8*

RECORD

Cased \_\_\_\_\_ in., \_\_\_\_\_ ft.

Sand \_\_\_\_\_

Gas \_\_\_\_\_

Oil \_\_\_\_\_

Total Depth 331'

PRODUCTION

1st 24 hrs. Nat. \_\_\_\_\_

1st 24 hrs. after shot \_\_\_\_\_

Gas \_\_\_\_\_ Cu. Ft.

Dry Hole \_\_\_\_\_

Abandoned \_\_\_\_\_

Date

NOV 18 1942 19

S. J. LEWIS Scout