


Woodson
Form 51-5M-2-29-34703
Map No. **KANSAS** Sec. **6** Twp. **24** R. **14**
Well No. **8 - Vigor shield** Farm
Ocala **B & R** Company

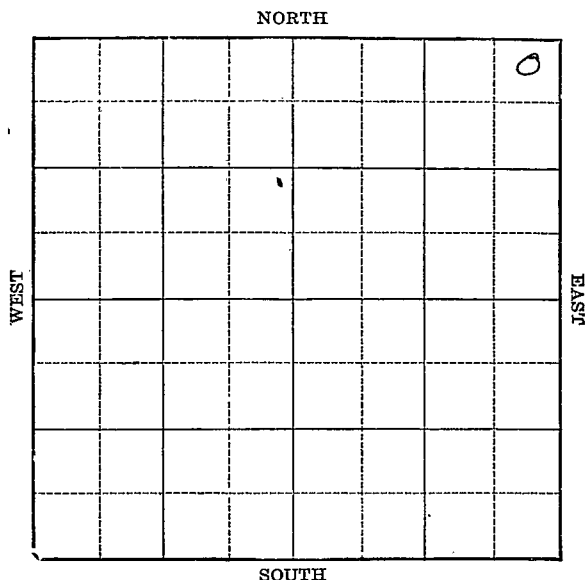

Location

Drilling Remarks

Rig Up

Drilling Remarks

RECORD

Cased in. ft.

Sand

Gas

Oil

Total Depth

PRODUCTION

1st 24 hrs. Nat.

1st 24 hrs. after shot

Gas cu. ft.

Dry Hole

Abandoned

Woodson
 MAP No. Kns SEC. 6 TWP. 24 R. 14
 WELL No. 8 Wintersheid
Okla PRR Co COMPANY

CONTRACTOR

FIRST REPORTS

SECTION PLAT

COMPLETED

_____ FT. FROM N. LINE

_____ FT. FROM S. LINE

_____ FT. FROM E. LINE

_____ FT. FROM W. LINE

			0

LOCATION _____

RIG UP _____

DRILLING AND REMARKS:

gas well.

RECORD

CASED _____ IN. _____ FT.

SAND 1555-1565

GAS _____

OIL _____

TOTAL DEPTH 1739

PRODUCTION

1ST 24 HRS. NAT. _____

1ST 24 HRS. AFTER SHOT _____

GAS 1/2 M 500 CU. FT.

DRY HOLE _____

ABANDONED _____

DATE

2/22/23 192

Shenwood

SCOUT