


Section 6 Township 24 Range 14-E

Well No. 10-Winterscheid

Company Woodson County Pipe Line

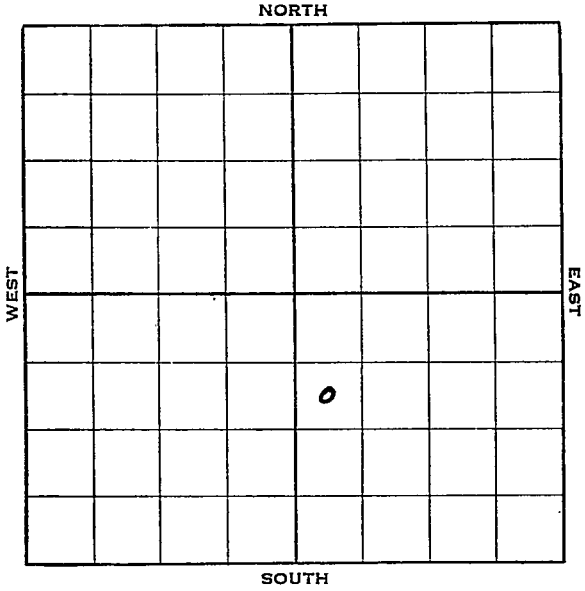



Map No. 17 Sec. 6 Twp. 24 R. 14E

Well No. 10 Winterscheid

Woodson County Pipe Line Company

**FIRST REPORT**

Contractor \_\_\_\_\_

**COMPLETED**

Approx.

SW NW SE

1180 Ft. from N. Line

\_\_\_\_\_ Ft. from S. Line

\_\_\_\_\_ Ft. from E. Line

525 Ft. from W. Line

**SECTION PLAT**

		0	

Location \_\_\_\_\_

**RECORD**

Rig up \_\_\_\_\_

Cased \_\_\_\_\_ in., \_\_\_\_\_ ft.

Drilling and Remarks:

Sand \_\_\_\_\_

Miss. & 6" 1671

Gas \_\_\_\_\_

Pay 1690-1713 T.O.

Oil \_\_\_\_\_

200' oil

Total Depth 1713

2500 acid

**PRODUCTION**

Est. 50 Oil

1st 24 hrs. Nat. \_\_\_\_\_

1st 24 hrs. after shot \_\_\_\_\_

Gas \_\_\_\_\_ Cu. Ft.

Dry Hole \_\_\_\_\_

Abandoned \_\_\_\_\_

Date

APR 20 1938 19

H. D. Hatfield

Scout

What is T.D. Don Schumaker

*[Handwritten scribbles and lines]*

Returned	_____
Cards	_____ <i>Paul</i>
Tracing	_____ <i>JM</i>
France Map	_____ <i>T.D.</i>
Scarborough Map	_____ <i>T.D.</i>
Moody Map	_____ <i>T.D.</i>
Scarborough Plat Book	_____
Moody Plat Book	_____

*[Handwritten marks]*