


2000

Map No. _____ Sec. 6 Twp. 24 R. 14

Well No. 10 Wintersheid Farm

Pure Oil Company

NORTH

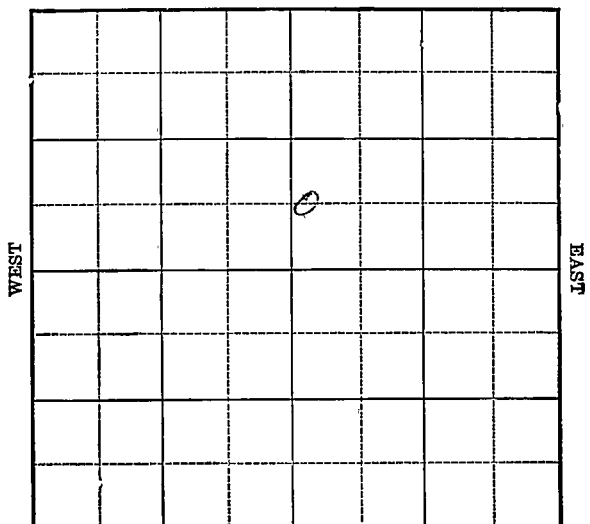

SOUTH

Location _____

Drilling Remarks

Rig Up _____

Drilling Remarks

RECORD

Cased _____ in. _____ ft.

Sand _____

Gas _____

Oil _____

Total Depth _____

PRODUCTION

1st 24 hrs. Nat. _____

1st 24 hrs. after shot _____

Gas _____ cu. ft.

Dry Hole _____

Abandoned _____

Map No. Kansas Sec. 6 Twp. 24 R. 14Well No. 10 - Wintersheid FarmPure oil Company

Ft. from N. Line

760 Ft. from S. Line

Ft. from E. Line

200 Ft. from W. Line

NORTH

WEST

EAST

SOUTH

Date

REPORT

5/5

machine

5/12

Same.

5/19

—

6/2

—

6/9

Sand 1707-1730 80 gts
100 bbls

Woodson
 normal KANSAS Sec. 6 Twp. 24 R. 14
 Map No.

Well No. 10 Winterfield
 Rube O D Co Company

Contractor

SECTION PLAT

		o	

Ft. from N. Line

760 Ft. from S. Line

Ft. from E. Line

200 Ft. from W. Line

FIRST REPORTS

Location

Rig up "Machine"

Drilling and Remarks:

RECORD

Cased _____ in., _____ ft.

Sand _____

Gas _____

Oil _____

Total Depth _____

PRODUCTION

1st 24 hrs. Nat. _____

1st 24 hrs. after shot _____

Gas _____ Cu. Ft.

Dry Hole _____

Abandoned _____

Date

MAY 5 1926

192

CHAS. L. SHERWOOD
Scout

Woodson
 normal
 Map No. **KANSAS** Sec. **6** Twp. **24** R. **14**
 Well No. **10** **Wintershed**
Hull **oil** **Co** Company

Contractor

COMPLETED

SECTION PLAT

Ft. from N. Line

766 Ft. from S. Line

Ft. from E. Line

200 Ft. from W. Line

		o	

Location

Rig up

Drilling and Remarks:

807100 ss.

RECORD

Cased _____ in., _____ ft.

Sand **1707-1730**

Gas _____

Oil _____

Total Depth **1730**

PRODUCTION

1st 24 hrs. Nat. _____

1st 24 hrs. after shot _____

Gas _____ Cu. Ft.

Dry Hole _____

Abandoned _____

Date

JUN 9 1926

CHAS. L. SHERWOOD

192

Scout