


Section 22 Township 29 S Range 4 E

Well No. #1 McKinley

Company Stelber

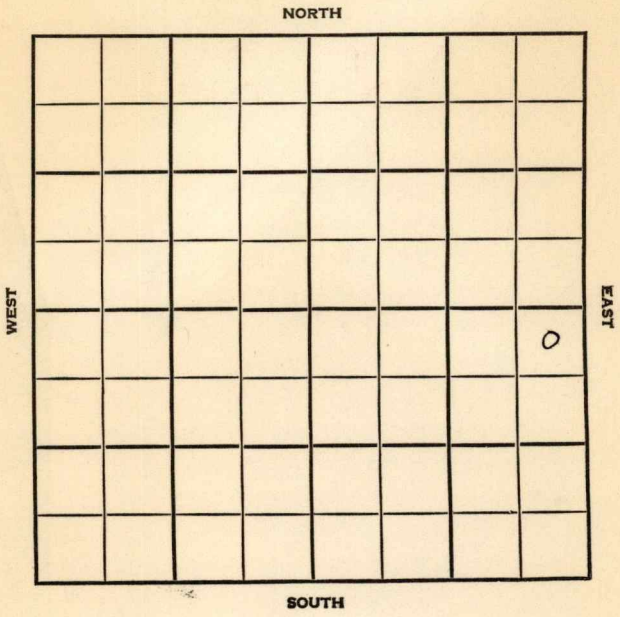

Butler

KANSAS

SEC. 22	TWP. 29S	R. 4E
------------	-------------	----------

WELL NO. #1 McKinley FARM

COMPANY Stelbar

CONTRACTOR N


Wildcat

\_\_\_\_\_ Ft. from N. Line

\_\_\_\_\_ Ft. from S. Line

\_\_\_\_\_ Ft. from E. Line

\_\_\_\_\_ Ft. from W. Line

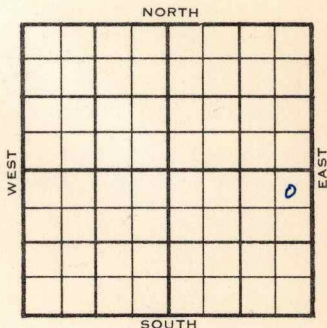

N E NE SE

	ELEVATION	REPORT
1955	1222 DF	

9/28  
 Comm 9-21-55  
 KC 2259  
 8" @ 53 w/50  
 D 2502

10/5  
 Comm 9-21-55  
 8" @ 53/50  
 KC 2259  
 BKC Bart 2778  
 M 2862  
 8" @ 53/50  
 D & A

ABANDONED

County **Butler** Elev. **1222 DF**  
 Sec. **22** Twp. **29S** Rge. **4E**  
 Company **Stelbar**  
 Farm Name **McKinley** No. **1**

TOPS	DEPTH	LOG	DATUM
Anh.			
Tp.			
H.			
Tr.			
Dg.			
Bl.			
L.			
K.C.	2259		
B.K.C.			
Ce.			
C.			
M.			
M.			
K.			
Mz.			
Mq.			
V.			
S.			
S.			
A.			
R.			
Pe.			
G.			
T.D.			

Loc. in Sec. **NE NE SE**  
~~**DS - SE/4**~~  
 Geol. \_\_\_\_\_  
 Contr. \_\_\_\_\_  
 Pool **Wildcat**  
 FIRST REPORT  
 0

Date Comm. **9-21-55** SEP 28 1955  
**8" 53 w/50; D 2502**

Co.  
 Lse.  
 No.  
 Sec.  
 T.  
 R.

