


Section #24 Township 29 Range 4E

Well No. #1 Berg

Company Holcomb & Copeland

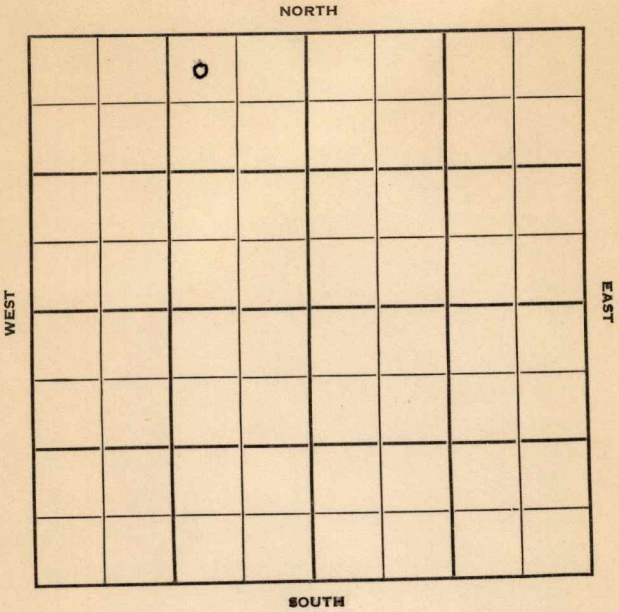

KANSAS

Butler

Sec. 24 Twp. 29 R. 4-E

Well No. #1 Berg Farm

Holcomb & Copeland Company

Contractor


330 Ft. from N. Line

Ft. from S. Line

990 Ft. from E. Line

Ft. from W. Line

NW NE NW

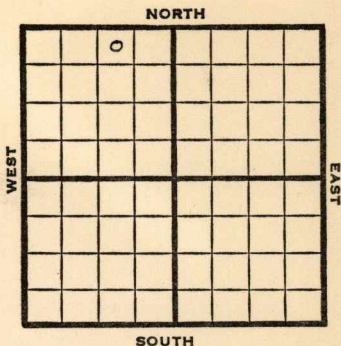

1950 **Elev 1282** REPORT

7/26 Spud 7-16-50
8 5/8" @ 78

KC 2274
drlg 2467

8/16 8 5/8" @ 78

KC 2274
Sd 2974
TD 3335
D&A

Miss 2909
Arb 3300

ABANDONED

Map No. _____ Sec. 24 Twp. 29 R. 4E


Well No. 1 Berg

Holcomb & Copeland Company

Contractor

NW NE NW

SECTION PLAT

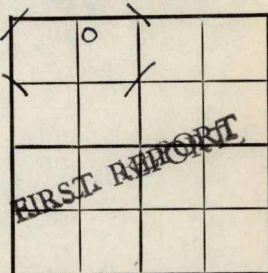

330 Ft. from N. Line

_____ Ft. from S. Line

990 Ft. from E. Line

_____ Ft. from W. Line

Butler County

RECORD

Location _____

Cased _____ in., _____ ft.

Rig up _____

Sand _____

Drilling and Remarks:

Gas _____

Spud 7-16-50

Oil _____

8 5/8" @ 78

Total Depth _____

EC 2274

PRODUCTION

drlg. 2467

1st 24 hrs. Nat. _____

1st 24 hrs. after shot _____

Gas _____ Cu. Ft.

Dry Hole _____

Abandoned _____

Date

JUL 26 1950 19

J. E. TYRA Scout

County Butler State Kansas

Sec. 24 (Blk. 29) (Sur. 4 E) Map No.

Operator Holcomb & Copeland

Well No. 1 Farm Berg

Elev. 1282 Location NW NE NW



330 Ft. From N Line NW

990 Ft. From E Line Quarter

1st. Report

Completion AUG 16 1950

Remarks

Spudding Date 7-16-50

Drlg. Data D & A TD 3335

8 5/8" @ 78 KC 2274 Miss. 2909

Sd. 2974 Arb. 3300 TD 3335

D & A

J. E. TYRA