



Woodson

Map No. KA Sec. 6 Twp. 24 R. 14

Well No. 12 Wintersheid Farm


Pure Oil Co. Company

320 Ft. from N. Line

..... Ft. from S. Line

..... Ft. from E. Line

200 Ft. from W. Line

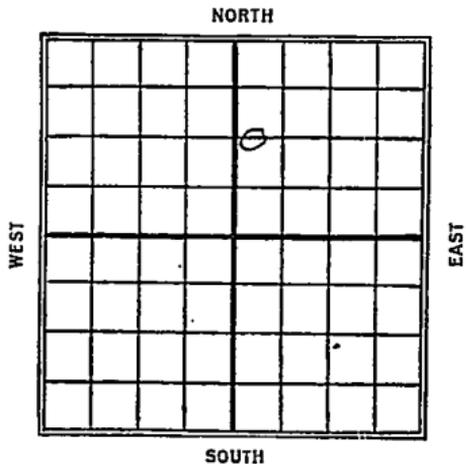

1926

Date	REPORT
------	--------

9/1 Location

9/15 ———

9/22 same

9/29 same

10/13 Sand 1724-1738

J.L. 1710

80/25 barrels

Woodson

KANSAS

Sec. 6 Twp. 24 R. 14

No. 12 Winton slide

Pull Oil Co

Company

Contractor

FIRST REPORTS

SECTION PLAT

1320

Ft. from N. Line

Ft. from S. Line

Ft. from E. Line

200

Ft. from W. Line

		5	

Location ✓

Rig up

Drilling and Remarks:

RECORD

Cased in, ft.

Sand

Gas

Oil

Total Depth

PRODUCTION

1st 24 hrs. Nat.

1st 24 hrs. after shot

Gas Cu. Ft.

Dry Hole

Abandoned

Date

SEP 1 1926

CHAS. L. SHERWOOD

Scout

Woodson

KANSAS


Map No. Sec. 6 Twp. 24 R. 14

Well No. 12 Winton Shels Farm

Rub Oil Co Company

NORTH

1320  
x  
200

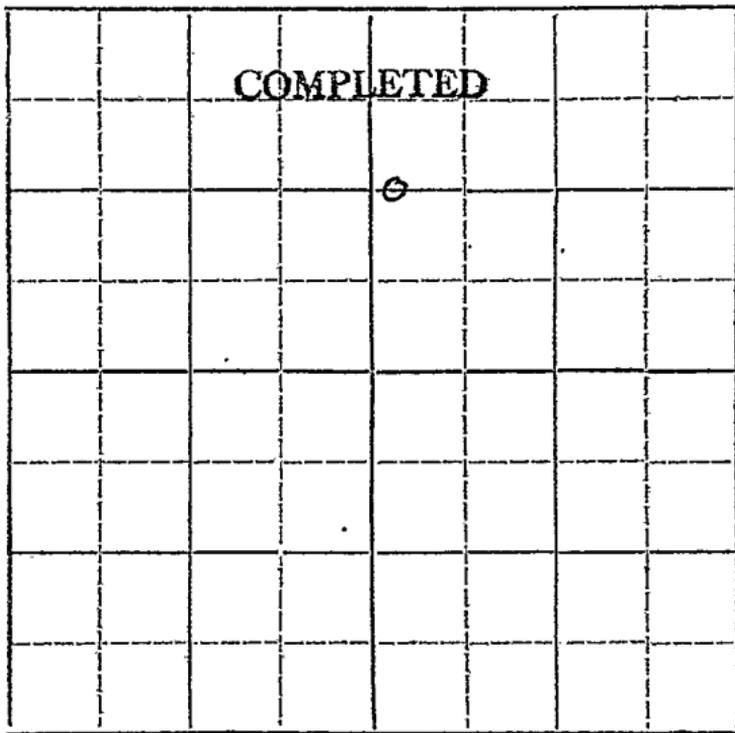

SOUTH

Location \_\_\_\_\_

Rig up \_\_\_\_\_

Drilling and Remarks:

+ L 1710

80 / 25 85

RECORD

Cased \_\_\_\_\_ in., \_\_\_\_\_ ft.  
 Sand 1724-1738  
 Gas \_\_\_\_\_  
 Oil \_\_\_\_\_  
 Total Depth 1740

PRODUCTION

1st 24 hrs. Nat. \_\_\_\_\_  
 1st 24 hrs. after shot \_\_\_\_\_  
 Gas \_\_\_\_\_ Cu. Ft.  
 Dry Hole \_\_\_\_\_  
 Abandoned \_\_\_\_\_

Date

OCT 13 1926

CHAS. L. SHERWOOD

Scout