


Section 6 Township 24 Range 14E

Well Number #17 Winterscheid

Company Pure Oil.

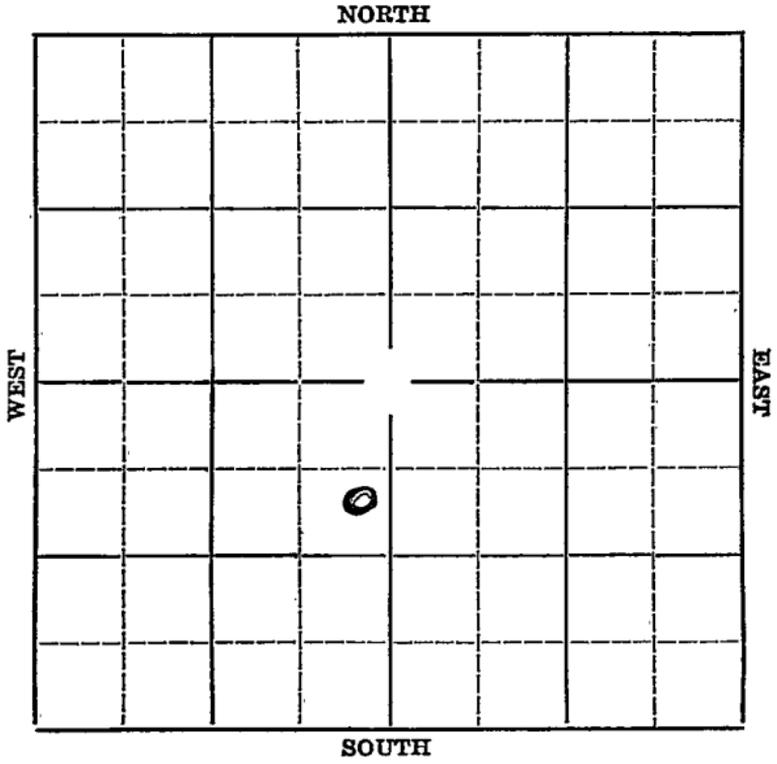

Map No. KANSAS Sec. 6 Twp. 24 R. 14E

Well No. #17 Wintersch ^{EID} ~~est.~~ Farm

Pure Oil.


Company

760' Ft. from N. Line

_____ Ft. from S. Line

200' Ft. from E. Line

_____ Ft. from W. Line

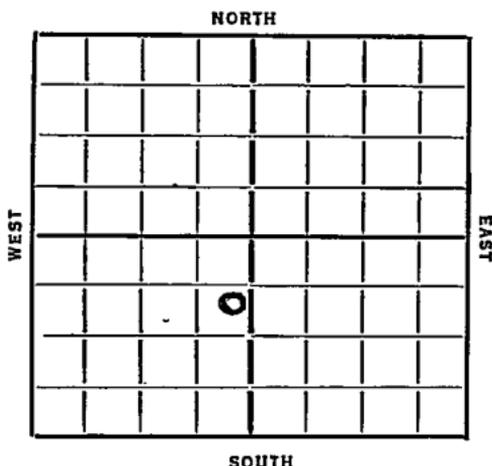

Date 1936

REPORT

5/20 Machine spud.

5/28 Drlg. 795'.

6/4 Drlg. 1138'.

6/11 Missl. Lime. 1675'. T.D. 1717'.

2000 gallons acid. No test.

6/17/36-Miss. Lime 1675'.

Pay 1692-1715'.

2000 gallons acid.

T.D. 1717'.

113 bbls oil in 18 hours.

COMPLETED

Woodson
Map No. 17 Sec. 6 Twp. 24 R. 14EWell No. 17 WinterscheidPure Oil CompanyWinterscheid Contractor

SECTION PLAT

760 Ft. from N. Line

_____ Ft. from S. Line

200 Ft. from E. Line

_____ Ft. from W. Line

FIRST REPORT

Location _____

Rig up _____

Drilling and Remarks:

Mack Speed

RECORD

Cased _____ in., _____ ft.

Sand _____

Gas _____

Oil _____

Total Depth _____

PRODUCTION

1st 24 hrs. Nat. _____

1st 24 hrs. after shot _____

Gas _____ Cu. Ft.

Dry Hole _____

Abandoned _____

Date

MAY 20 1936 19

S. J. LEWIS

Scout

Goodson
 Map No. 17 Sec. 6 Twp. 24 R. 14E

Well No. 17 Winterhead

Pure Oil Company

Contractor

760 Ft. from N. Line
 _____ Ft. from S. Line
200 Ft. from E. Line
 _____ Ft. from W. Line

SECTION PLAT

COMPLETED

Location _____

Rig up _____

Drilling and Remarks:

Miss 1695
Pay 1692-1715
2000 acid
11388 to 18 hrs

RECORD

Cased _____ in., _____ ft.

Sand _____

Gas _____

Oil _____

Total Depth 1717

PRODUCTION

1st 24 hrs. Nat. _____

1st 24 hrs. after shot _____

Gas _____ Cu. Ft.

Dry Hole _____

Abandoned _____

Date

WIN 17 1936₁₉

S. J. LEWIS Scout