

Map No. **KANSAS** Sec. *24* Twp. *29*^S R. *4*^E


Well No. *15 Guthrie* Farm

S. A. Ross Company

NORTH

WEST

EAST

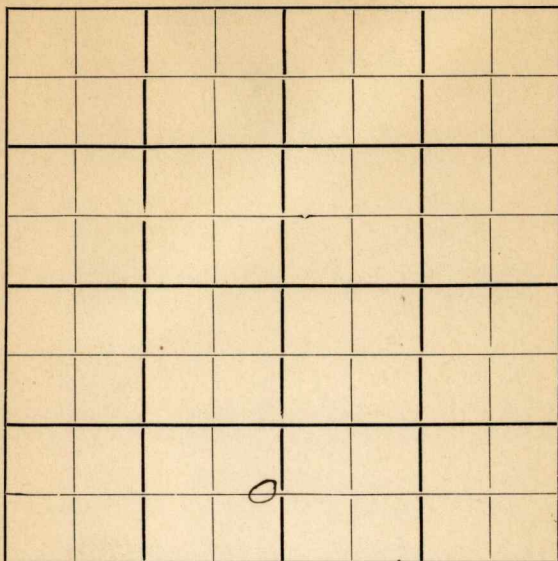

SOUTH

Location.....

Drilling Remarks

.....

.....

Rig Up.....

Drilling Remarks

.....

.....

RECORD

Cased..... in..... ft.

Sand.....

Gas.....

Oil.....

Total Depth.....

PRODUCTION

1st 24 hrs. Nat.....

1st 24 hrs. after shot.....

Gas..... cu. ft.....

Dry Hole.....

Abandoned.....

Map No. Sec. Twp. R.

Well No. Farm


..... Company

..... Ft. from N. Line

..... Ft. from S. Line

..... Ft. from E. Line

..... Ft. from W. Line

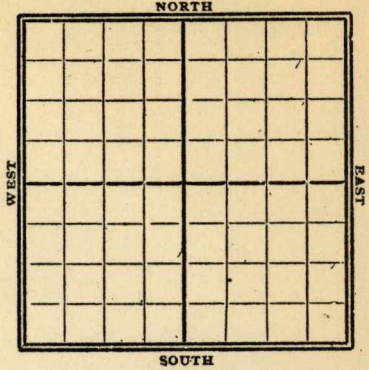

1922

Date

REPORT

Gypsy Records

6/19

Abd T.D. 2989'

Cowley

MAP NO. KANSAS SEC. 24 TWP. 29S R. 4E

WELL NO. 1 *Yuthie*
C. J. Ross COMPANY

CONTRACTOR

ABANDONED SECTION PLAT

_____ FT. FROM N. LINE
_____ FT. FROM S. LINE
_____ FT. FROM E. LINE
_____ FT. FROM W. LINE

no record

LOCATION _____
RIG UP _____
DRILLING AND REMARKS:

RECORD

CASED _____ IN. _____ FT.
SAND _____
GAS _____
OIL _____
TOTAL DEPTH. 2989

PRODUCTION

1ST 24 HRS. NAT. _____
1ST 24 HRS. AFTER SHOT _____
GAS _____ CU. FT.
DRY HOLE _____
ABANDONED 2989

DATE 6/19 192 _____ SCOUT