

Woodson


Form 51-5M-2-29-34703

Map No. KANSAS Sec. 6 Twp. 24 R. 14E

Well No. 13 - Kunterscheid Farm

Wire Oil Company

NORTH

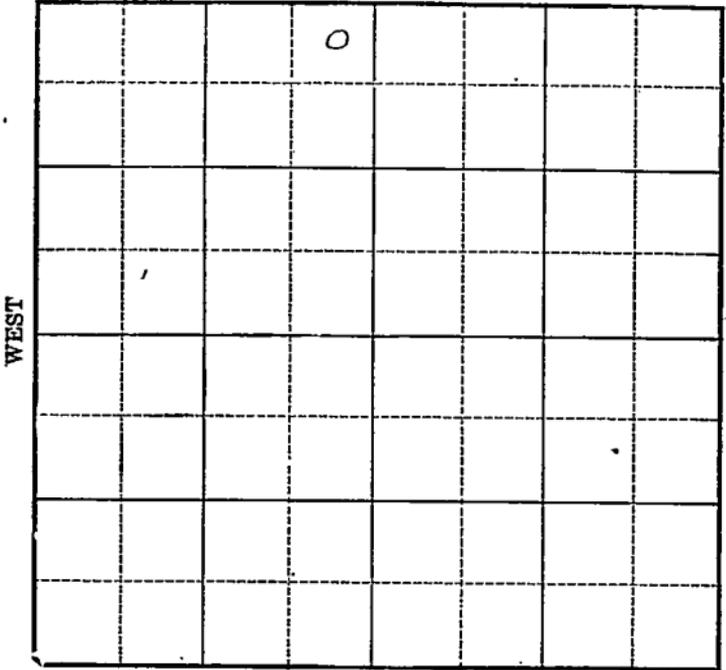

SOUTH

O. W. D. D

Location \_\_\_\_\_

Drilling Remarks \_\_\_\_\_

\_\_\_\_\_

\_\_\_\_\_

RECORD

Cased \_\_\_\_\_ in. \_\_\_\_\_ ft.

Sand \_\_\_\_\_

Gas \_\_\_\_\_

Oil \_\_\_\_\_

Total Depth \_\_\_\_\_

Rig Up \_\_\_\_\_

Drilling Remarks \_\_\_\_\_

\_\_\_\_\_

\_\_\_\_\_

PRODUCTION

1st 24 hrs. Nat. \_\_\_\_\_

1st 24 hrs. after shot \_\_\_\_\_


Gas \_\_\_\_\_ cu. ft. \_\_\_\_\_

Dry Hole \_\_\_\_\_

Abandoned \_\_\_\_\_

Map No. **KANSAS** Sec. 6 Twp. 24 R. 14<sup>E</sup>  
Well No. 13-Wintershed Farm  
Pure Oil Company

250 Ft. from N. Line  
\_\_\_\_ Ft. from S. Line  
250 Ft. from E. Line  
\_\_\_\_ Ft. from W. Line

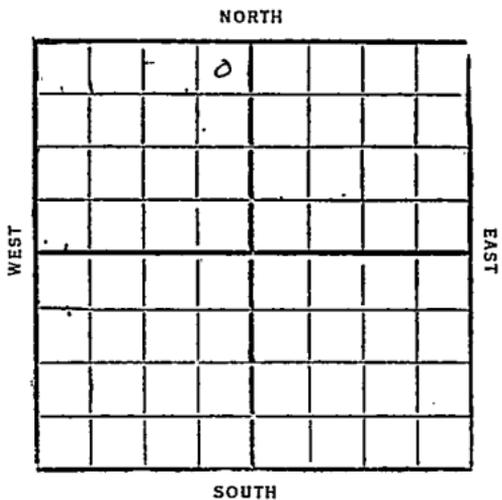

1932

Date	REPORT	O. W. D. D
6/15	Ry. mach	
6/22	Dreg 390'	
6/29	" 775'	
7/16	Stand 1563-80	
	1200' ft oil & sks water	
7/13	Stand 1563-80'	
	717/1580	
	Pump 25 bbl oil	
	Comp.	
<b>1937</b>	<b>O. W. D. D</b>	
8/25	O.T.D. 1580'.	
	5" @ 1675'.	
	T.D. 1700'.	
	U. R. 5" .	
9/3	" "	
9/10	Miss & 5" @ 1721'.	T.D. 1765'.
	S.O. & W. C.O.	
9/17	" " "	

**OVER**

1937

9/22 Old T.D. 1580'.  
Drilled to Total Depth 1765'.  
3000 acid.  
26 oil & 118 water.

COMPLETED

~~ABANDONED~~  
COMPLETED

COMPLETED

*Woodson*

*17* KANSAS Sec. *6* Twp. *74* R. *14* E

Well No. *13* *Ninterscheis*

*Quero Oil Co* Company

Contractor

FIRST REPORTS

*250* Ft. from N. Line

..... Ft. from S. Line

*250* Ft. from E. Line

..... Ft. from W. Line

SECTION PLAT

	0		

Location.....

Rig up.....

Drilling and Remarks:

*Drilling up 2 1/2 in.*

RECORD

Cased..... in., ..... ft.

Sand.....

Gas.....

Oil.....

Total Depth.....

PRODUCTION

1st 24 hrs. Nat.....

1st 24 hrs. after shot.....

Gas..... Cu. Ft.

Dry Hole.....

Abandoned.....

Date

JUN 15 1932

192 CHAS. L. SHERWOOD Scout

*Goodson*

E

17

KANSAS

Map No. .... Sec. *6* Twp. *24* R. *14*

Well No. *13 Winterscheis*

*Pure Oil Co* Company  
 Contractor

COMPLETED

SECTION PLAT

*750* Ft. from N. Line  
 ..... Ft. from S. Line  
*750* Ft. from E. Line  
 ..... Ft. from W. Line

	0		

Location .....  
 Rig up .....  
 Drilling and Remarks:

*Pump 25 lbs*

RECORD *42*

Cased ..... in., ft.  
 Sand *1563-1580*  
 Gas .....  
 Oil .....  
 Total Depth *1580*

PRODUCTION

1st 24 hrs. Nat. ....  
 1st 24 hrs. after shot .....  
 Gas ..... Cu. Ft.  
 Dry Hole .....  
 Abandoned .....

Date

JUL 13 1932

CHAS. L. SHERWOOD

192

Scout

Woodson **KANSAS**

Map No. 17 Sec. 6 Twp. 24 R. 14E

Well No. 13- Winterschied

Pure Oil

Company

**FIRST REPORT**

Contractor

ne nw

**SECTION PLAT**

		0	

250 Ft. from N. Line

\_\_\_\_\_ Ft. from S. Line

250 Ft. from E. Line

\_\_\_\_\_ Ft. from W. Line

- O W D D -

Location \_\_\_\_\_

Rig up \_\_\_\_\_

Drilling and Remarks:

O W D D (Bart-1563)

O + D 1580

5" 1675

+ D 1700

O.P. 5"

**RECORD**

Cased \_\_\_\_\_ in., \_\_\_\_\_ ft.

Sand \_\_\_\_\_

Gas \_\_\_\_\_

Oil \_\_\_\_\_

Total Depth \_\_\_\_\_

**PRODUCTION**

1st 24 hrs. Nat. \_\_\_\_\_

1st 24 hrs. after shot \_\_\_\_\_

Gas \_\_\_\_\_ Cu. Ft.

Dry Hole \_\_\_\_\_

Abandoned \_\_\_\_\_

Date

AUG 25 '37

H. D. Hatfield

AUG 25 1937 19

Scout

Map No. 17 Sec. 6 Twp. 24 R. 14E

Well No. 13-Winterscheid

Pure oil

Company \_\_\_\_\_

Contractor \_\_\_\_\_

SECTION PLAT

	0		

250 Ft. from N. Line

\_\_\_\_\_ Ft. from S. Line

250 Ft. from E. Line

\_\_\_\_\_ Ft. from W. Line

**COMPLETED**

CWPO

Location \_\_\_\_\_

Rig up \_\_\_\_\_

Drilling and Remarks:

3000 and

26 oil  
118 water

RECORD

Cased \_\_\_\_\_ in., \_\_\_\_\_ ft.

Sand \_\_\_\_\_

Gas \_\_\_\_\_

Oil \_\_\_\_\_

Total Depth 1765

PRODUCTION

1st 24 hrs. Nat. \_\_\_\_\_

1st 24 hrs. after shot \_\_\_\_\_

Gas \_\_\_\_\_ Cu. Ft.

Dry Hole \_\_\_\_\_

Abandoned \_\_\_\_\_

Date

**SEP 22 1937**