



Woodson

Map No. KANSAS Sec. 6 Twp. 24 R. 14<sup>E</sup>

Well No. 15 Wintersheid Farm


Pure Oil Company

649 Ft. from N. Line

\_\_\_\_\_ Ft. from S. Line

197 Ft. from E. Line

\_\_\_\_\_ Ft. from W. Line

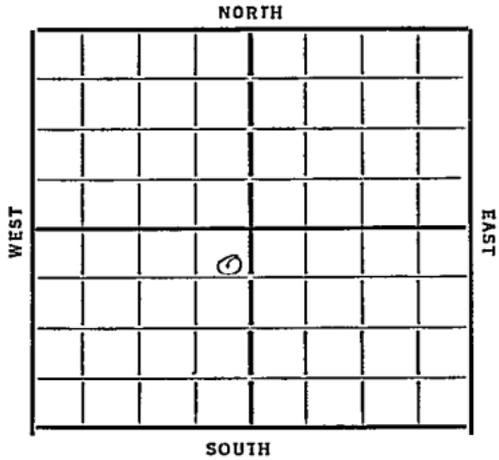

Date 1/23

REPORT

1/28

Rig

12/6

Wreg 180'

12/12

" 730'

12/27

" 1485

1/4

Top Line 1681 - 8" at 1683

show oil 1711-28

Treated with 1000 gal acid

1934

1/17

Line 1681

T. D. 1728 1000 gallon

acid 36 bbls

COMPLETED

Map No. 17 Sec. 6 Twp. 24 R. 14E

Well No. 15-Winterscheid

Pure Oil Company

Contractor


SECTION PLAT

**FIRST REPORTS**  
649 Ft. from N. Line

..... Ft. from S. Line

197 Ft. from E. Line

..... Ft. from W. Line

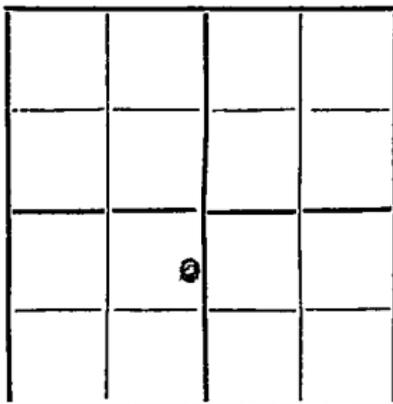

Location.....

Rig up

Drilling and Remarks:

RECORD

Cased..... in., ..... ft.

Sand.....

Gas.....

Oil.....

Total Depth.....

PRODUCTION

1st 24 hrs. Nat.....

1st 24 hrs. after shot.....

Gas..... Cu. Ft.

Dry Hole.....

Abandoned.....

Date

11-28-33 C. W. Winterscheid  
 Scout

Map No. 17 Sec. 6 Twp. 24 R. 14 E

Well No. 15-Winterscheid

pure oil Company

Contractor

SECTION PLAT


649 Ft. from N. Line

Ft. from S. Line

197 Ft. from E. Line

Ft. from W. Line

**COMPLETED**

Location

Rig up

Drilling and Remarks:

1000 gal oil

36 bbls

RECORD

Cased in. ft.

Sand Line 1681

Gas

Oil

Total Depth 1728

PRODUCTION

1st 24 hrs. Nat.

1st 24 hrs. after shot

Gas Cu. Ft.

Dry Hole

Abandoned

Date

1-17-34 192 O. Marmescher Scout