


Section 25 Township 29 Range 4 E

Well No. # 1 Gillum Rowe

Company Adair

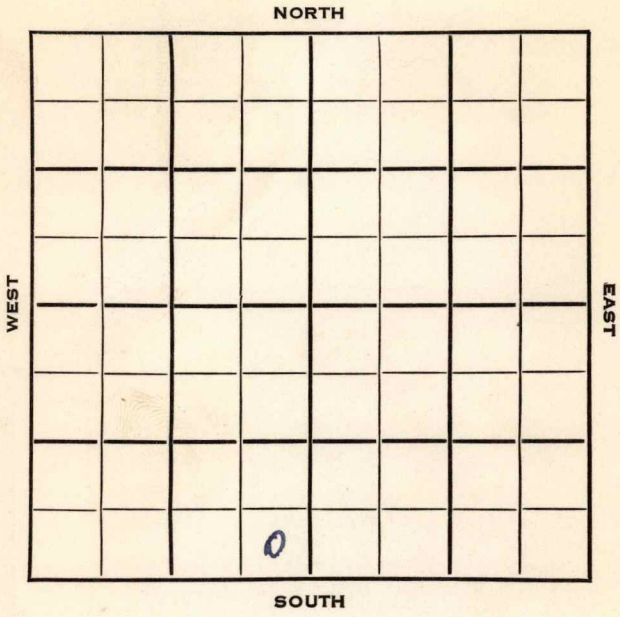

Butler

KANSAS




| | | |
|------|------|-----|
| SEC. | TWP. | R. |
| 25 | 29 | 4 E |

WELL NO. # 1 ~~Gilman~~ Rowle FARM

COMPANY Adair

CONTRACTOR Adair

_____ Ft. from N. Line
 330 _____ Ft. from S. Line
 330 _____ Ft. from E. Line
 _____ Ft. from W. Line

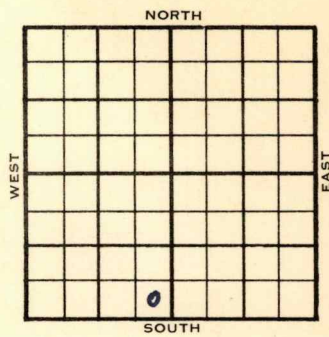

SE SE SW

| | ELEVATION | REPORT |
|-------|---------------------------------------|--------|
| 1953 | 1244' | |
| 10/21 | Spud 10-19-53 | |
| 12/9 | Spud 10-19-53 | |
| | Oil Well | |
| | TD 2769' | |
| | KC 2231', Cherokee 2671', Bart 2758', | |
| | TD 2769' | |
| | 5" @ 2759', | |
| | CO to 2769, FU 200' oil 1 1/4 hrs. | |
| | PB 2765 | |
| | dol-frac 40 bo 4 hrs. | |
| | Comp. 25 bopd | |

COMPLETED

ANSAS

Map No. _____ Sec. 25 Twp. 29 R. 4E

Well No. 1 Rowe

Adair Company

CORRECTION Contractor

SE SE SW

SECTION PLAT

_____ Ft. from N. Line

330 Ft. from S. Line

330 Ft. from E. Line

_____ Ft. from W. Line

| | | | |
|--|--|--|--|
| | | | |
| | | | |
| | | | |
| | | | |

Butler County

Location _____

Rig up _____

Drilling and Remarks:

Reported

#1 Gillum

RECORD

Cased _____ in., _____ ft.

Sand _____

Gas _____

Oil _____

Total Depth _____

PRODUCTION

1st 24 hrs. Nat. _____

1st 24 hrs. after shot _____

Gas _____ Cu. Ft.

Dry Hole _____

Abandoned _____

Date

NOV 18 1953 19

J. G. McGEHEE

Scout

