


Woodson

Form 51-5M-11-31-Palace

Map No. **KANSAS** Sec. 6 Twp. 24 R. 14 E

Well No. 16 Winterscheid Farm
Pure Oil Co Company

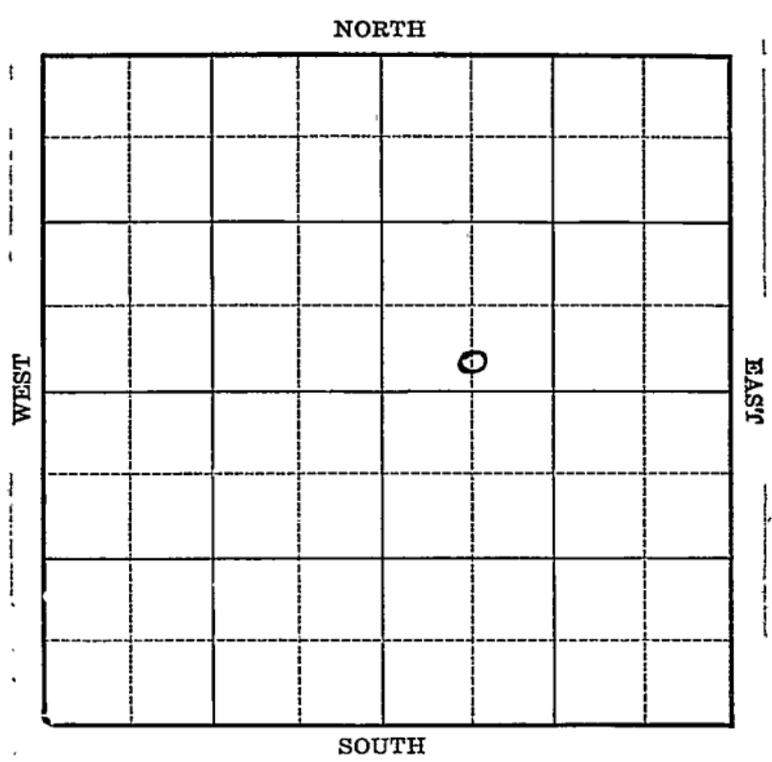

Location _____

Drilling Remarks _____

Rig Up _____

Drilling Remarks _____

RECORD

Cased _____ in. _____ ft.

Sand _____

Gas _____

Oil _____

Total Depth _____

PRODUCTION

1st 24 hrs. Nat. _____

1st 24 hrs. after shot _____

Gas _____ cu. ft.

Dry Hole _____

Abandoned _____

Goodson

Map No. KANSAS Sec. 6 Twp 24 R. 14


Well No. 16 Hinterscheid Farm
Pure Oil Co. Company

_____ Ft. from N. Line

250 Ft. from S. Line

_____ Ft. from E. Line

660 Ft. from W. Line

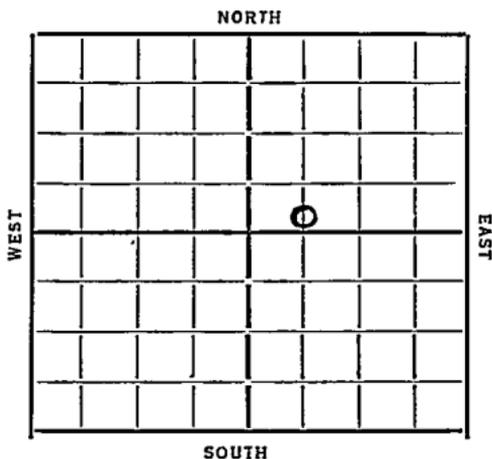

Date
1934

REPORT

2/10 Machine

2/23 Drlg 360

3/1 NR 10" at 828

3/8 Drlg 1300

3/21 Limer 1683 Pay 1900-2495
2000 Gal acid 100 Bbls.

COMPLETED

Map No. 17 Sec. 6 Twp. 27 R. 14E

Well No. 16 - Wintercheid

Pure Oil Company

Contractor

SECTION PLAT

FIRST REPORT

Ft. from N. Line

250 Ft. from S. Line

Ft. from E. Line

660 Ft. from W. Line

		o	

RECORD

Location.....

Cased.....in.,ft.

Rig up.....

Sand.....

Drilling and Remarks:

Gas.....

Oil.....

Total Depth.....

Machine

PRODUCTION

1st 24 hrs. Nat.....

1st 24 hrs. after shot.....

Gas.....Cu. Ft.

Dry Hole.....

Abandoned.....

Date

2-14-34 192 O. Mannscheck Scout

Woodson

Map No. 17 Sec. 6 Twp. 24 R. 14 E

Well No. 16-Winterscheid

Pure oil Company

Contractor

COMPLETED

SECTION PLAT

		0	

_____ Ft. from N. Line

250 Ft. from S. Line

_____ Ft. from E. Line

660 Ft. from W. Line

Location _____

Rig up _____

Drilling and Remarks:

2000 acid

100 bbls

RECORD

Cased _____ in., _____ ft.

Sand line 1683

Gas Ray 1700-24

Oil _____

Total Depth 1724

PRODUCTION

1st 24 hrs. Nat. _____

1st 24 hrs. after shot _____

Gas _____ Cu. Ft.

Dry Hole _____

Abandoned _____

Date

3/21/37 1937 O. Marmeluch Scout