


Section 6 Township 24 Range 14-E

Well Number #18-Winterscheid

Company Pure

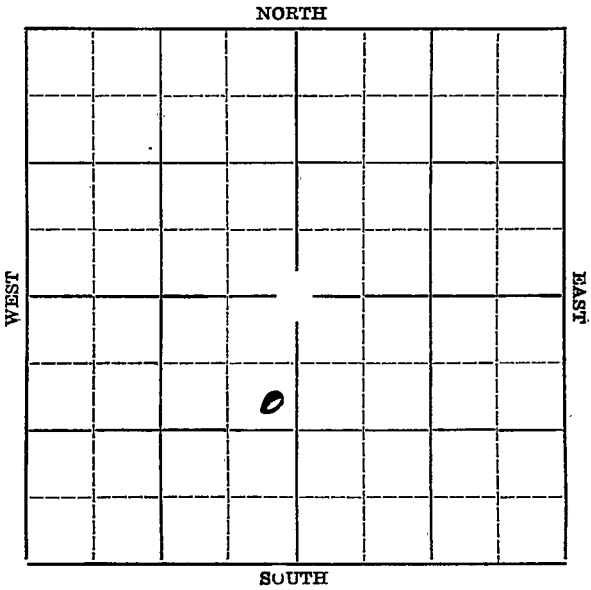

KANSAS

Map No. _____ Sec. 6 Twp. 24 R. 14E

Well No. #18 Winterscheid Farm _____

Pure


Company _____

1200' Ft. from N. Line

_____ Ft. from S. Line

200
~~300~~ Ft. from E. Line

_____ Ft. from W. Line

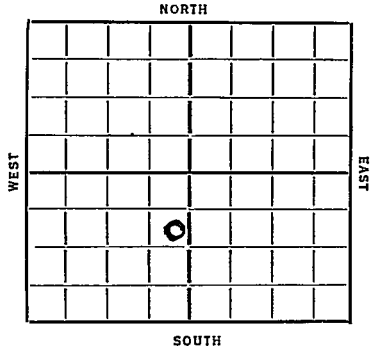

Date
1936

REPORT

6/17 Drlg. 160'.

6/25 Drlg. 370'.

7/2 Drlg. 1500'.

7/9 Drlg. 1800'.

7/15/36-Miss. Lime. 1674'.

T.D. 1724'.

2000 gallons of acid.

100 bbls of oil potential.

COMPLETED

KANSAS

Map No. 17 Sec. 6 Twp. 24 R. 14EWell No. 18 WinterscheidPure Company

Contractor

SECTION PLAT

1200 Ft. from N. Line

_____ Ft. from S. Line

200 Ft. from E. Line

_____ Ft. from W. Line

FIRST REPORT

Location _____

Rig up _____

Drilling and Remarks:

Tr 9/60

RECORD

Cased _____ in., _____ ft.

Sand _____

Gas _____

Oil _____

Total Depth _____

PRODUCTION

1st 24 hrs. Nat. _____

1st 24 hrs. after shot _____

Gas _____ Cu. Ft.

Dry Hole _____

Abandoned _____

Date

JUN 17 1936₁₉

S. J. LEWIS.

Scout

Woodson

Map No. 17 Sec. 6 Twp. 24 R. 14E

Well No. 18 Winterschied

Pure Oil Company

Contractor

SECTION PLAT

1200 Ft. from N. Line

_____ Ft. from S. Line

200 Ft. from E. Line

_____ Ft. from W. Line

COMPLETED

Location _____

Rig up _____

Drilling and Remarks:

Miss L 1674
2000 acid
100886

RECORD

Cased _____ in., _____ ft.

Sand _____

Gas _____

Oil _____

Total Depth 1724

PRODUCTION

1st 24 hrs. Nat. _____

1st 24 hrs. after shot _____

Gas _____ Cu. Ft.

Dry Hole _____

Abandoned _____

Date

JUL 15 1936 19

S. J. LEWIS Scout