

Woodson


KANSAS

Form 51-5M 5-37 Petrol

Section 6 Township 24 Range 14-E

Well No. 19-Winterscheid

Company Pure Oil

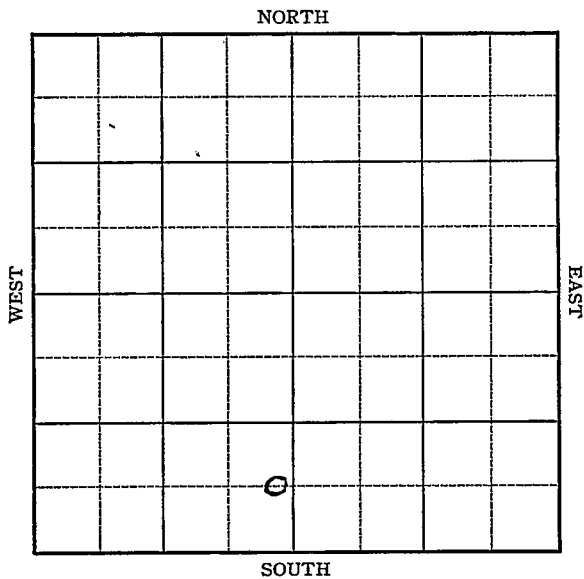



Woodson

KANSAS

Map No. 17 Sec. 6 Twp. 24 R. 14E

Well No. 19-Winterscheid

Pure oil

Company

Contractor

SECTION PLAT


Ft. from N. Line

660 Ft. from S. Line

200 Ft. from E. Line

Ft. from W. Line

1st Report Completion

COMPLETION

Location

Rig up

Drilling and Remarks:

3000 acid

85 oil  
14 water

RECORD

Cased in. ft.

Sand 1716

Gas

Oil

Total Depth 1720

PRODUCTION

1st 24 hrs. Nat.

1st 24 hrs. after shot

Gas Cu. Ft.

Dry Hole

Abandoned

Date

SEP 22 1937

19

H. D. Hatfield

Scout