

KANSAS

Barton


FORM 51 5M 10-41 PETROL

Section 5 Township 17 Range 11-W

Well No. #1 Radenberg

Company Texas

NORTH Kraft Prusa Pool

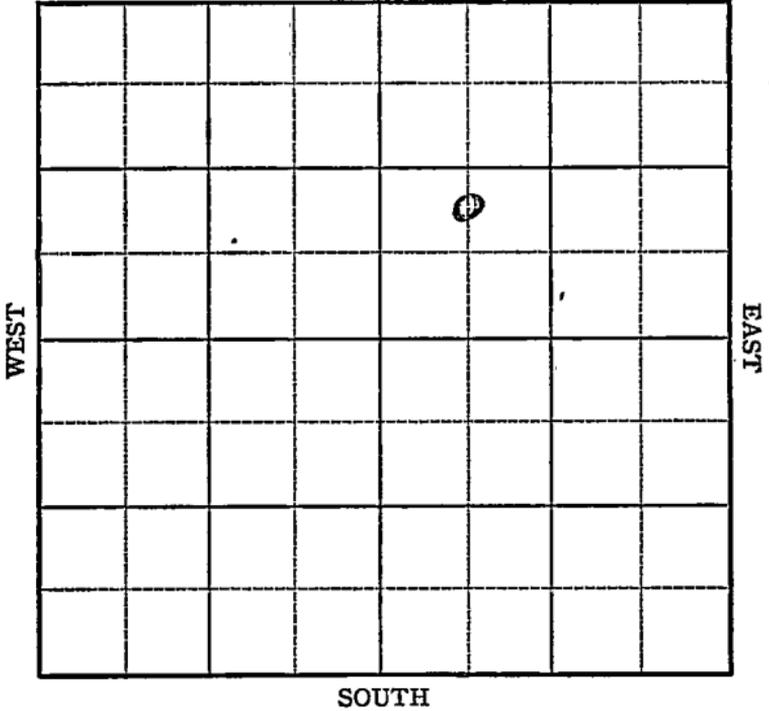

Sec. 5 Twp. 17 R. 11-W

Well No. #1 Radenberg Farm

Texas Company


(Kraft Prusa)

 Ft. from N. Line

990 Ft. from S. Line

 Ft. from E. Line

660 Ft. from W. Line

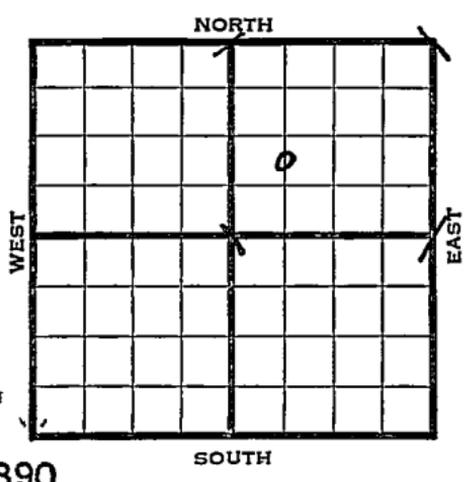

Elev 1890

1942	REPORT
3/25	Location
4/8	10" - 330' Drlg. 2060'
4/15	Lans. 3046' S.S.O. 3076-80'
	Drlg. 3230'
4/22	Arb. 3394'
	T.D. 3397'
	Water.
	ABANDONED

Map No. 55 Sec. 5 Twp. 17 R. 11W

Well No. 1 Radenberg

Texas


Company

FIRST REPORT

Contractor

C NL SW NE

SECTION PLAT

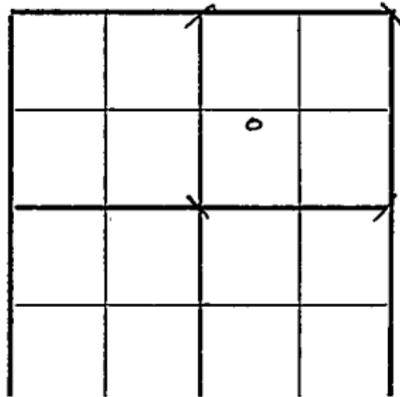

_____ Ft. from N. Line

990 Ft. from S. Line

_____ Ft. from E. Line

660 Ft. from W. Line

KRAFT PRUSA POOL

RECORD

Location XXX

Cased _____ in., _____ ft.

Rig up _____

Sand _____

Drilling and Remarks:

Gas _____

Oil _____

Total Depth _____

PRODUCTION

1st 24 hrs. Nat. _____

1st 24 hrs. after shot _____

Gas _____ Cu. Ft.

Dry Hole _____

Abandoned _____

Date

MAR 25 1942 19

S. J. LEWIS

Scout

Barton

KANSAS

Map No. 55 Sec. 5 Twp. 17 R. 11WWell No. 1 Radenberg

Texas

Company

ABANDONED

Contractor

C NL SW NE

SECTION PLAT

_____ Ft. from N. Line

990 Ft. from S. Line

_____ Ft. from E. Line

660 Ft. from W. Line

		o	

KRAFT PRUSA POOL

Location _____

Rig up _____

Drilling and Remarks:

*Cr & 3394**Water.*

RECORD

Cased _____ in., _____ ft.

Sand _____

Gas _____

Oil _____

Total Depth 3392

PRODUCTION

1st 24 hrs. Nat. _____

1st 24 hrs. after shot _____

Gas _____ Cu. Ft.

Dry Hole _____

Abandoned _____

Date

APR 22 1942 19S. J. LEWIS Scout