

KANSAS


FORM 51 5M 10-41 PETROL

Butler

Section 31 Township 29 Range 4-E

Well No. #1 Blood

Company E. V. Shawver

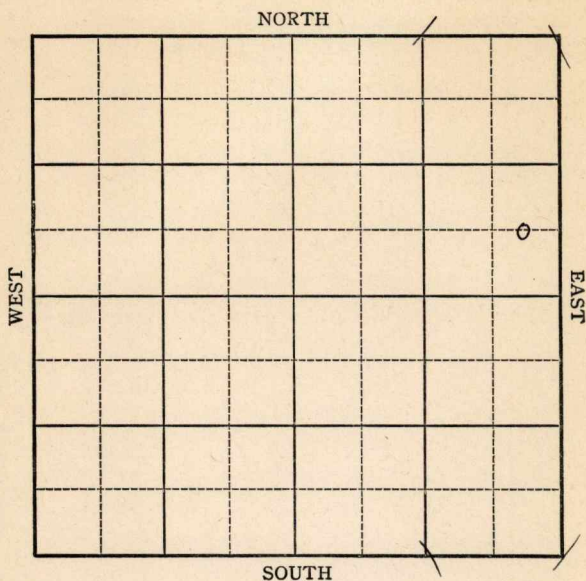

KANSAS

Bulter

Sec. 31 Twp. 29 R. 4-E

Well No. #1 Blood Farm

E. V. Shawver Company

Miscellaneous


 Ft. from N. Line

660 Ft. from S. Line

330 Ft. from E. Line

 Ft. from W. Line

C EL SE NE

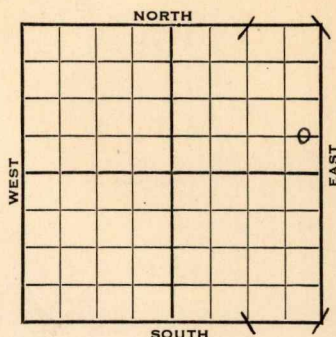

1943

Elev. 1173

REPORT

1/20

12" Casing set 43'
Drlg. 1750'

1/27

KC 2205
Miss 2725?
Drlg. 2830'

2/3

Miss. 2780
Arb 3043
T.D. 3056'
No shows.

ABANDONED

Butler


KANSAS

Map No. Sec. 31 Twp. 29 R. 4EWell No. 1 BloodE. V. Shawver Company

Contractor

C EL SE NE

SECTION PLAT

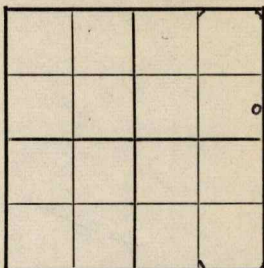 Ft. from N. Line660 Ft. from S. Line330 Ft. from E. Line Ft. from W. Line

MISCELLANEOUS

RECORD

Location Rig up

Drilling and Remarks:

12"-43'Dr1g. 1750'Cased in., ft.Sand Gas Oil Total Depth


PRODUCTION

1st 24 hrs. Nat. 1st 24 hrs. after shot Gas Cu. Ft.Dry Hole Abandoned

Date

JAN 20 1943 19S. J. LEWIS

Scout

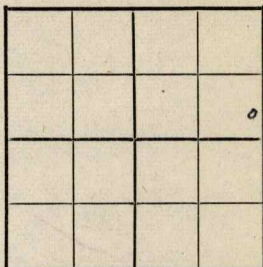KANSASMap No. 11 Sec. 31 Twp. 29 R. 4EWell No. 1 BloodE. V. Shawver CompanyABANDONED Contractor**C E L S E N E****SECTION PLAT** Ft. from N. Line660 Ft. from S. Line330 Ft. from E. Line Ft. from W. Line**MISCELLANEOUS**Location Rig up

Drilling and Remarks:

*Miss 2750**Core 3043**Noe hours***RECORD**Cased in., ft.Sand Gas Oil Total Depth 3056**PRODUCTION**1st 24 hrs. Nat. 1st 24 hrs. after shot Gas Cu. Ft.Dry Hole Abandoned

Date

FEB 3 1943 19S. J. LEWIS Scout