


Butler

KANSAS

SECTION 29 TOWNSHIP 29S RANGE 4E

WELL NO. #1 Blood

COMPANY Stelbar

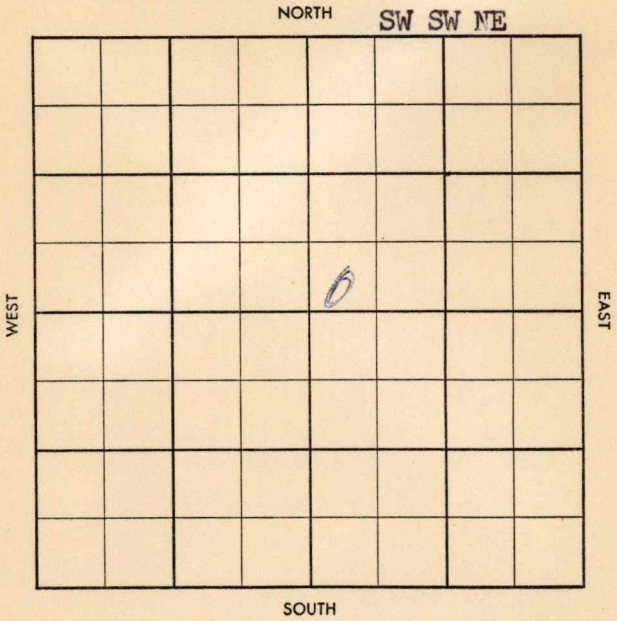


Twp. X Pool X

Co. X Facet X

S-513-B

County Butler Elev. 1178 DE 1181 RB
 Sec. 29 Twp. 29 Rge. LE
 Company Stelbar
 Farm Name Blood No. 1

TOPS	DEPTH	LOG	DATUM
Anh.			
Tp.			
H.			
Tr.			
Dg.			
B.L.			
L.	<u>1962</u>	<u>1900</u>	
K.C.	<u>2175</u>	<u>2136</u>	
B.K.C.		<u>2404</u>	
Ce.			
C.			
M.	<u>2712</u>	<u>2712</u>	
M. <u>chart</u>		<u>2738</u>	
K.		<u>2918</u>	
Mz.			
Mq.			
V.			
S.			
S.			
A.	<u>3014</u>	<u>3010</u>	
R.			
Pf.			
G.			
T.D.	<u>3031</u>	<u>3033</u>	

Loc. in Sec. SW SW NE
 Geol. 
 Contr. Co. Tools
 Pool Blood
Blot
 COMPLETE
 MAY 21 '58

Date Comm. 3/23/58 (Shell - DW)
8" x 250 W 175 DST 2734-
50' op 18" g/l 7" oil 1/16"
lec 1950' oil FP 669-970
BHP 1100-1100/30" d 2.860
APR 9 '58 4" 2826/125 APR 19 '58 1700'
W 1/16 40/2735-45 F10
~~100 in 3~~ 180 per min g
37° S1 APR 23 '58 APR 30 '58 7/40 ho
thru cap. 7/77 ho new lv.

MAY 7 '58 ~~MAY 14 '58~~ MAY 21 '58 Bottom Hole Bomb

3424 BOPD

in 37°

SW SW NE

29-29-4E

Top ~~X~~ Pool ~~X~~

Co. ~~X~~ Facet ~~X~~

WILDCAT

S-513-B

County Butler Elev. _____
 Sec. 29 Twp. 29 Rge. 4E
 Company Stelbar
 Farm Name Blood No. 1

TOPS	DEPTH	LOG	DATUM
Anh.			
Tp.			
H.			
Tr.			
Dg.			
B.L.			
L.			
K.C.			
B.K.C.			
Ce.			
C.			
M.			
M.			
K.			
Mz.			
Mq.			
V.			
S.			
S.			
A.			
Rp.			
Pf.			
G.			
T.D.			

Loc. in Sec. SW SW NE

Geol. _____

Contr. _____

Co. Tools

Pool _____

Wildcat

FIRST REPORT

MAR 26 58

Date Comm. 3/23/58 (Shell - DHM)

8" @ 250 w/175 WOC

Co.
Lse.
No.
Sec.
T.
R.