

KANSAS

FORM 51 5M 4-41 PETROL

Barton

Section 5 Township 17 Range 11-W

Well No. #1 Radenberg

Company G.E. Ash


Kraft Prusa Pool

NORTH

16

WEST

EAST

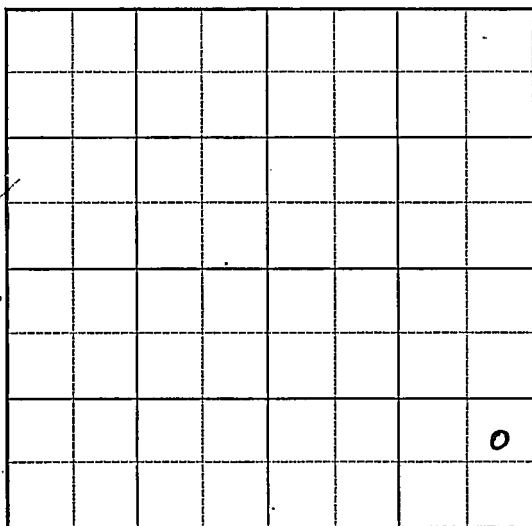

SOUTH

Sec. 5 Twp. 17 R. 11-WWell No. #1 Radenberg FarmC. E. Ash Company


(Kraft-Prusa)

Ft. from N. Line

960 Ft. from S. Line330 Ft. from E. Line

Ft. from W. Line

Elev. 1874

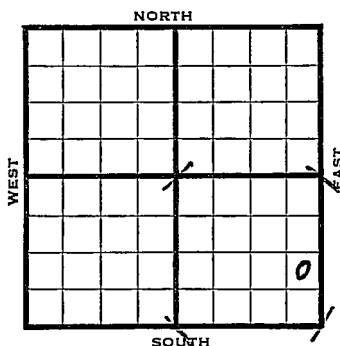

1942

REPORT

6/24

Location

7/1

Rotary.

7/8

8" - 257' Drlg. 2318'

7/15

Lans. 3051' Arb. 3312' T.D. 3330' SO
5" - 3315' RUST.

7/22

" " "

7/29

T.D. 3331' 1000' oil 10 hrs
3000 acid.

8/5

Arb. 3312'

5" - 3315'

T.D. 3331'

3000 acid

Pump 180 Pot.

Gravity 43.4

COMPLETED

KANSAS

Barton


Map No. 55 Sec. 5 Twp. 17 R. 11WWell No. 1 RadenbergC. E. Ash

Company

FIRST REPORT

Contractor

NE SE SE

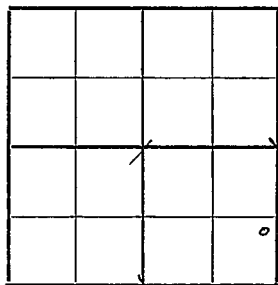SECTION PLAT Ft. from N. Line960 Ft. from S. Line330 Ft. from E. Line Ft. from W. Line**KRAFT PRUSA POOL**Location XXXRig up

Drilling and Remarks:

RECORDCased in., ft.Sand Gas Oil Total Depth **PRODUCTION**1st 24 hrs. Nat. 1st 24 hrs. after shot. Gas Cu. Ft.Dry Hole Abandoned

Date

S. J. LEWISJUN 24 1942 19

Scout

Barton

KANSAS

Map No. 55 Sec. 5 Twp. 17 R. 11WWell No. 1 RadenbergC. E. Ash CompanyCOMPLETED Contractor

NE S E S E

SECTION PLAT

 Ft. from N. Line960 Ft. from S. Line330 Ft. from E. Line Ft. from W. Line

KRAFT PRUSA POOL

Location Rig up

Drilling and Remarks:

*Cor 3312**5110 3315.**3000 acil**Pump 180 Pst**43 1/2 Lr*

RECORD

Cased in., ft.Sand Gas Oil Total Depth 3331

PRODUCTION

1st 24 hrs. Nat. 1st 24 hrs. after shot Gas Cu. Ft.Dry Hole Abandoned

Date

AUG 5 1942 19S. J. LEWIS Scout