

KANSAS

Barton


FORM 51 5M 10-41 PETROL

Section 5 Township 17 Range 11W

Well No. #2 Radenberg

Company Ash & Crown
Kraft Prusa Pool

NORTH

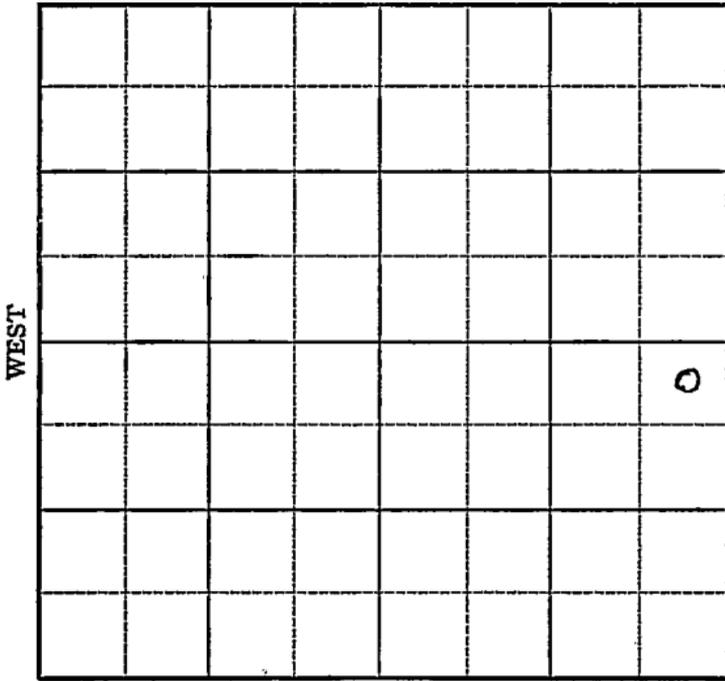

9

WEST

EAST

0

SOUTH

Sec. 5 Twp. 17 R. 11-W

Well No. #2 Radenberg Farm

Ash & Crown Company

(Kraft Prusa Pool)


330 Ft. from N. Line

_____ Ft. from S. Line

330 Ft. from E. Line

_____ Ft. from W. Line

Elev. 1884

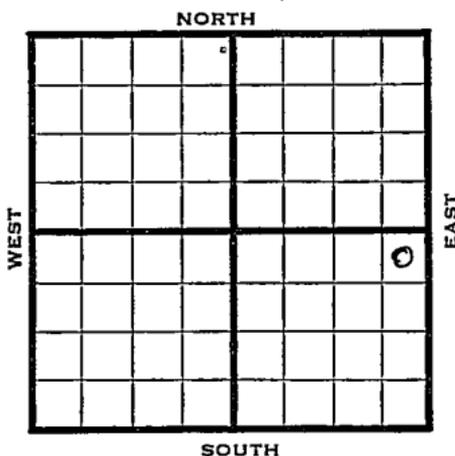

1942

REPORT

8/5 8" 260'
Waiting on cement

8/12 " " "

8/19 - Anhy 715'
Drlg. 2760'.

8/27 Arb 3318-24 TD 5" @ 3320 Rust
9/2 TD 3326 2900' oil 11 hrs.

9/9 Arb 3315 corrected
TD 3326 5" @ 3320'

9/16 Arb. 3315 5" - 3320'
Depth Pot. 3000
TD 3326
Gravity 43.6

COMPLETED

Barton

KANSAS

Map No. 55 Sec. 5 Twp. 17 R. 11W

Well No. 2 Radenberg

Ash & Crown Company

FIRST REPORT Contractor

NE SE

SECTION PLAT

330 Ft. from N. Line

_____ Ft. from S. Line

330 Ft. from E. Line

_____ Ft. from W. Line

			o

KRAFT PRUSA POOL

Location _____

Rig up _____

Drilling and Remarks:

8"-260'

Waiting on
cement

RECORD

Cased _____ in., _____ ft.

Sand _____

Gas _____

Oil _____

Total Depth _____

PRODUCTION

1st 24 hrs. Nat. _____ "

1st 24 hrs. after shot _____

Gas _____ Cu. Ft.

Dry Hole _____

Abandoned _____

Date

AUG 5 1942 19

S. J. LEWIS Scout

Barton

KANSAS

Map No. 55 Sec. 5 Twp. 17 R. 11WWell No. 2 RadenbergAsh & Crown CompanyCOMPLETED Contractor

SECTION PLAT

NE SE

330 Ft. from N. Line

_____ Ft. from S. Line

330 Ft. from E. Line

_____ Ft. from W. Line

			o

KRAFT PRUSA POOL

Location _____

Rig up _____

Drilling and Remarks:

Cor 43315'
5" @ 3320
Dep. H. P. 43000

43 6/8

RECORD

Cased _____ in., _____ ft.

Sand _____

Gas _____

Oil _____

Total Depth 3326

PRODUCTION

1st 24 hrs. Nat. _____

1st 24 hrs. after shot _____

Gas _____ Cu. Ft.

Dry Hole _____

Abandoned _____

Date

SEP 16 1942 19S. J. LEWIS Scout