

KANSAS


FORM 51 5M 10-41 PETROL

Barton

Section 5 Township 17 Range 11-W

Well No. 2 Schneeweiss

Company Black Marshall

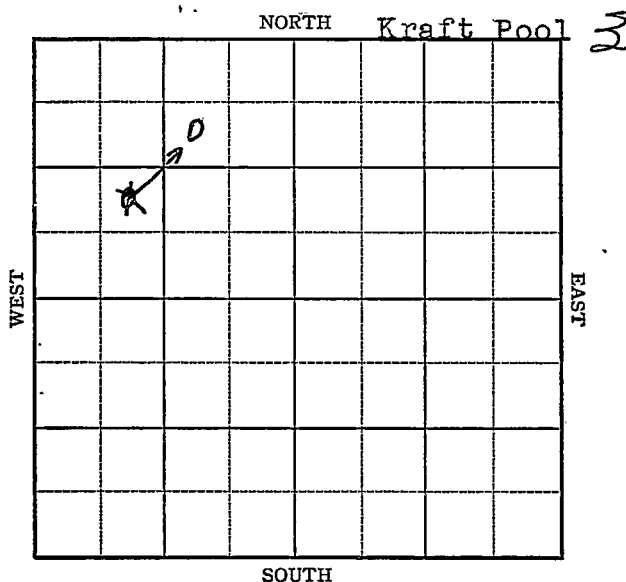

KANSAS

Barton

Sec. 5 Twp. 17 R. 11-W

Well No. #2 Schneeweiss Farm

Black Marshall Company

(Kraft)


990 Ft. from N. Line

~~990~~ Ft. from S. Line

990 Ft. from E. Line

~~990~~ Ft. from W. Line

Elw. 1909

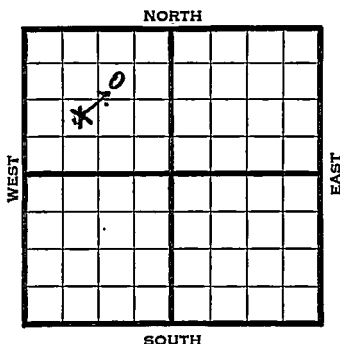

1941	REPORT
12/30	Rotary
1942	
1/8	"
1/15	"
1/22	10" - 298' Anhy 760'
	Drlg. 1307'
1/29	Drlg. 2702'
2/5	Arb. 3345-58' T.D. 5" - 3348' RUST.
2/12	T.D. 3360' 2000 acid.
2/19	Shut down.
2/26	" "
3/5	" "
3/12	" "
3/19	" "
3/26	" "
	OVER

1942

4/1

Arb. 3345'

5" - 3348'

T.D. 3360'

2000 acid.

Potential 500 bbls., pump.

43.6 Gravity

COMPLETED

Barton

KANSAS

Map No. 55 Sec. 5 Twp. 17 R. 11WWell No. 2 SchneeweissBlack Marshall CompanyFIRST REPORT Contractor

NE SW NW

SECTION PLAT

0			

 Ft. from N. Line990 Ft. from S. Line Ft. from E. Line990 Ft. from W. Line

KRAFT POOL

RECORD

Location Cased in., ft.Rig up Sand

Drilling and Remarks:

Gas Oil Total Depth

Rotary

PRODUCTION

1st 24 hrs. Nat. 1st 24 hrs. after shot Gas Cu. Ft.Dry Hole Abandoned

Date

DEC 30 1941

19

S. J. LEWIS Scout

Map No. 537 Sec. 5 Twp. 17 R. 11WWell No. 2 SchneeweissBlack-Marshall

Company

Contractor

SW NE NW

990 Ft. from N. Line Ft. from S. Line990 Ft. from E. Line Ft. from W. Line

SECTION PLAT

	o		

KRAFT POOL

Location Rig up

Drilling and Remarks:

Reported

NE SW NW

RECORD

Cased in., ft.Sand Gas Oil Total Depth

PRODUCTION

1st 24 hrs. Nat. 1st 24 hrs. after shot Gas Cu. Ft.Dry Hole Abandoned

Date

JAN 7 1942 19 S. J. LEWIS Scout

Barton

KANSAS

Map No. 5-5 Sec. 5 Twp. 17 R. 11WWell No. 2 SchneeweissBlack Marshall CompanyCOMPLETED Contractor

SW NE NW

SECTION PLAT

	0		

990 Ft. from N. Line Ft. from S. Line990 Ft. from E. Line Ft. from W. LineKRAFT PRUSA POOLLocation Rig up

Drilling and Remarks:

Cu 3345
5" @ 3348
2000 Acid
Pump 500 P.D.

43 6 Gr

RECORD

Cased in., ft.Sand Gas Oil Total Depth 3360

PRODUCTION

1st 24 hrs. Nat. 1st 24 hrs. after shot Gas Cu. Ft.Dry Hole Abandoned

Date

APR 1 1942 19 S. J. LEWIS Scout