


Section 32 Township 29 Range 4E

Well No. #2 Eckels

Company Kornfield Bros.

Miscellaneous NORTH

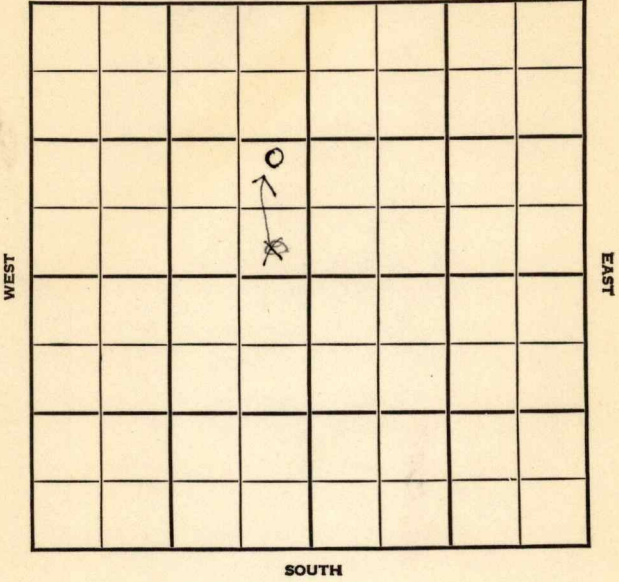

KANSAS

Butler

Sec. 32 Twp. 29 R. 4E

Well No. #2 Eckels Farm
Kornfield Bros. Company

Miscellaneous

Ft. from N. Line

1250

~~330~~

Ft. from S. Line


400

~~330~~

Ft. from E. Line

Ft. from W. Line

~~SE NW~~ NE SE NW

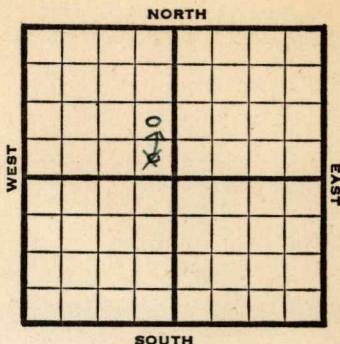

1947

Elev. 1176' REPORT

1/7 Drlg. 1700'

1/14 Arbuckle 2965-67'

TD 2965-67'

5" @ 2965'

RUST

1/21 "

1/26 "

2/4 Arb. 2965'

TD 2976'

Abd.

ABANDONED

Map No. _____ Sec. 32 Twp. 29 R. 4E

Well No. 2 Eckels

Kornfield Bros. Company

FIRST REPORT Contractor

SE NW

SECTION PLAT

_____ Ft. from N. Line

330 Ft. from S. Line

330 Ft. from E. Line

_____ Ft. from W. Line

Butler County

Location _____

Rig up _____

Drilling and Remarks:

drlg. 1700

RECORD

Cased _____ in., _____ ft.

Sand _____

Gas _____

Oil _____

Total Depth _____

PRODUCTION

1st 24 hrs. Nat. _____

1st 24 hrs. after shot _____

Gas _____ Cu. Ft.

Dry Hole _____

Abandoned _____

Date

JAN 7 1948 19

S. J. LEWIS Scout

