


Section 6 Township 17 Range 11-W

Well No. 1 Demel

Company Texas Kraft pool

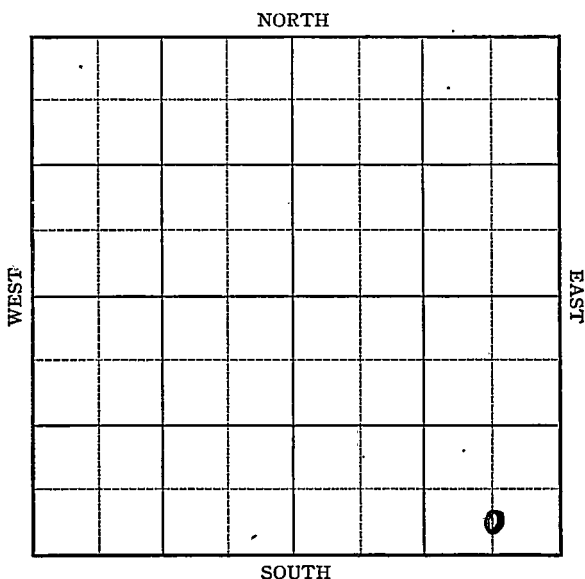

Texas

Company

Kraft pool


_____ Ft. from N. Line

330 Ft. from S. Line

660 _____ Ft. from E. Line

Ft. from W. Line

Elev. 1875

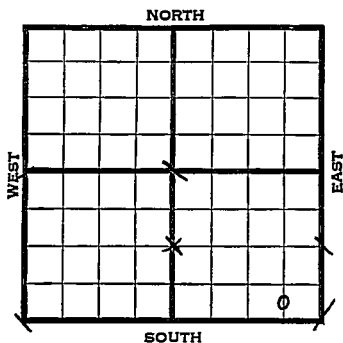[illegible]

Map No. 55 Sec. 6 Twp. 17 R. 11WWell No. 1 Demel

Texas

Company

FIRST REPORT

Contractor

C S L SE SE


Ft. from N. Line

330 Ft. from S. Line660 Ft. from E. Line

Ft. from W. Line

KRAFT POOL

SECTION PLAT

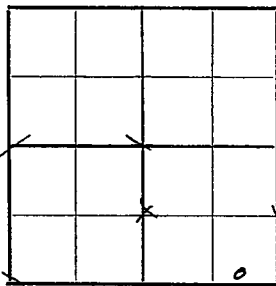

Location

Rig up

Drilling and Remarks:

Rigging up
Rotary

RECORD

Cased _____ in., _____ ft.

Sand _____

Gas _____

Oil _____

Total Depth _____

PRODUCTION

1st 24 hrs. Nat. _____

1st 24 hrs. after shot _____

Gas _____ Cu. Ft.

Dry Hole _____

Abandoned _____

Date

AUG 13 1944

S. J. LEWIS Scout

Map No. _____ Sec. 6 Twp. 17 R. 11WWell No. 1 DemelTexas

Company _____

ABANDONED

Contractor _____

C S L SE SE

_____ Ft. from N. Line

330 Ft. from S. Line660 Ft. from E. Line

_____ Ft. from W. Line

KRAFT POOL

SECTION PLAT

Location _____

Rig up _____

Drilling and Remarks:

*Cr X 8339**Water*

RECORD

Cased _____ in., _____ ft.

Sand _____

Gas _____

Oil _____

Total Depth 3352

PRODUCTION

1st 24 hrs. Nat. _____

1st 24 hrs. after shot _____

Gas _____ Cu. Ft.

Dry Hole _____

Abandoned _____

Date

SEP 3 194119S. J. LEWIS

Scout