


Section 7 Township 17 Range 11W

Well No. #1 Boor

Company Mouser Drlg.

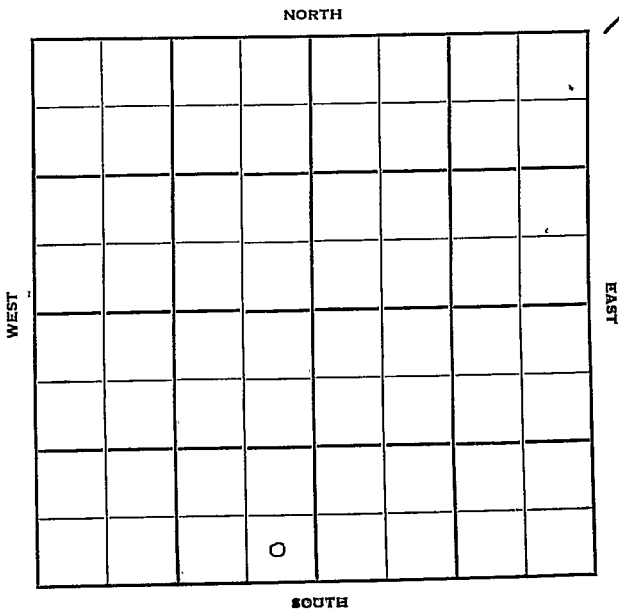

Barton

KANSAS

Sec. 7 Twp. 17 R. 11 W ✓

Well No. # 1 Boor Farm

Mouser Drlg. Company

Wildcat Contractor


Ft. from N. Line

330 Ft. from S. Line

330 Ft. from E. Line

Ft. from W. Line

SE SE SW

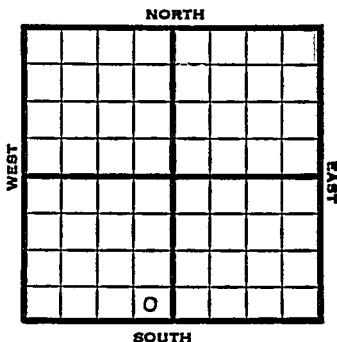

1951

Elev. 1838' REPORT

8/8

Location

8/29

Spud 8-16-51
D&A TD 3403
8" @ 210
Heeb. 2926
Br lime 3025
KC 3038
Cong. 3296
Arb. 3377-3403 TD
D&A

ABANDONED

J. E. TYRA

J. E. TYRA