FORM 51 25M 3-49 PETROL

Ellis
O.W.W.O.


KANSAS

Section 36 Township 12 Range 20W

Well No. #1 Weisner

Company ~~Jones & Shelborne~~ FLYNN Oil

Wildcat

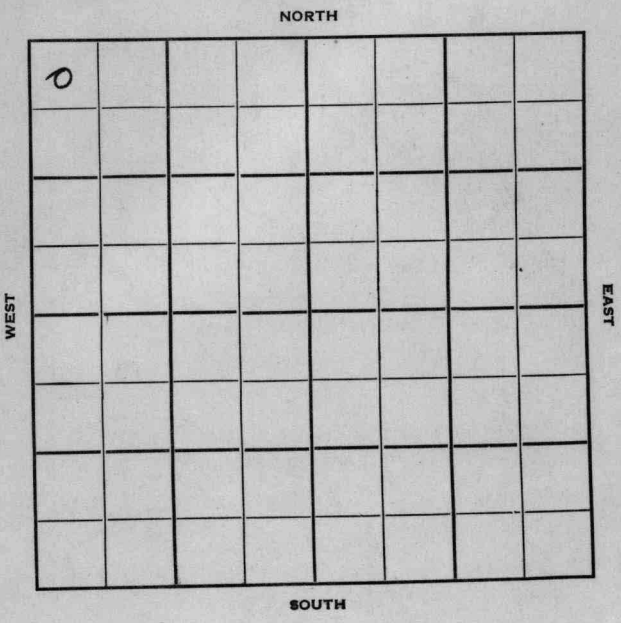

FORM 252-A
5M 10-48 PETROL

O.W.W.O. Ellis KANSAS

Sec. 36 Twp. 12 R. 20W

Well No. #1 Weisner Farm

Flynn Oil
Jones & Shelborne Company

Wildcat (Jones & Shelborne, Contr.)


330' Ft. from N. Line

_____ Ft. from S. Line

_____ Ft. from E. Line

330' Ft. from W. Line

NW/C

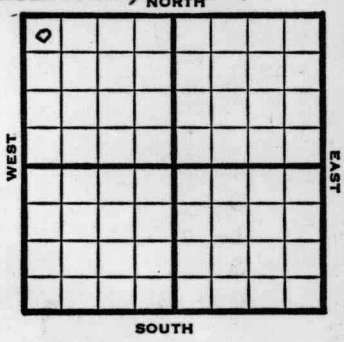

1949	Elev. 2170' REPORT
12/14	Location
12/28	Lans. 3494' Arb. 3917' TD 3945' ABANDONED O.W.W.O.
1952 4/9	Lans. 3494 Cong 3842 Simp Sd 3891 Arb. 3917 OTD 3947 5" @ 3915 was D&A To CO Test
4/23	5" @ 3930' 18/3882-90 S/10 BOPH 23/3882-90 Fill up 620' oil 3 hrs. 24/3882-90 S/10½ BO 1st hr. S/11 BO 2nd hr. S/14 BO 3 hr. 30/3863-68 18/3873-76 S/4.7 BO plus 1/2 BWPH for 10 hrs. POP
4/30	NR
5/7	"
5/14	NR
5/21	"
5/28	NR
6/11	"
6/18	"
6/25	"
7/2	"
7/9	"
7/17	"

OVER

1952

7/23 NR
7/30 NR
8/6 P/14 BO & 60 Bwpd
8/13 NR
8/20 NR
8/27 "
9/3 "
9/10 Sq. all perfs.
9/17 NR
9/24 D&A TD 3947'
Lans. 3494 Cong. 3842
Simp. 3891 Arb. 3917
OTD 3947' 5" @ 3915' D&A
CO 5" @ 3930 48/ 3882-90
S/ 10 boph 23/ 3882-90
FU 620' oil 3 hr. 24/ 3882-90
S/ 10½ bo 1 hr. S/ 4 bo 2nd hr.
S/ 14 bo 3rd hr. 30/ 3863-68
18/ 3873-76 S/ 4.7 bo ½ bwph
P/ 14 bopd 60 bw 30/ 3858-63 dry
6/ 3879-80 wtr. 48/ 3872-80
Sd-Frac. 200 A 4 bwph 12 goph
24/ 3888-92 D&A

ABANDONED

O.W.W.O.

FORM 275 FOR SALE BY KANSAS BLUE PRINT CO.

County **Ellis** State **Kansas**

Sec. **36** (Blk. Twp.) **12** (Sur. Rge.) **20W** Map No.

Operator **Flynn Oil**

Well No. **1** Farm **Weisner**

Elev. **2170** Location **NW NW NW**



330 Ft. From **N** Line **NW**

330 Ft. From **W** Line Quarter

1st. Report **APR 9** **1952**

Completion

Remarks **OWWO** O.W.W.O.

Alyward - Contr.

Spudding Date

Drlg. Data **Wildcat**

Lans 3494 Cong 3842 Simp sd 3891 Arb 3917

OTD 3947 5" @ 3915 was D&A to Co test

J. G. McGEHEE

Form 26 200 Bks. 6-49 Petrol

Kansas

Wildcat

Map No. _____ Sec. 36 Twp. 12 R. 20W

Well No. 1 Weisner


Jones & Shelborne Company

Jones & Shelborne Contractor

NW/C

FIRST REPORT

SECTION PLAT

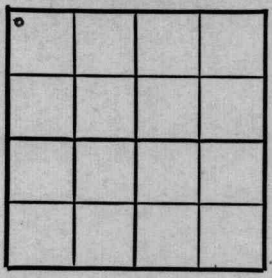

330 Ft. from N. Line

_____ Ft. from S. Line

_____ Ft. from E. Line

330 Ft. from W. Line

Ellis County

Location x

Rig up _____

Drilling and Remarks:

RECORD

Cased _____ in., _____ ft.

Sand _____

Gas _____

Oil _____

Total Depth _____

PRODUCTION

1st 24 hrs. Nat. _____

1st 24 hrs. after shot _____

Gas _____ Cu. Ft.

Dry Hole _____

Abandoned _____

Date

DEC 14 1949 19

S. J. LEWIS Scout

Form 26 200 Bks. 6-49 Petrol

Kansas

Wildcat

Map No. _____ Sec. 36 Twp. 12 R. 20W

Well No. 1 Weisner


Jones & Shelborne Company

ABANDONED Contractor

NW/C

E, 2170

SECTION PLAT

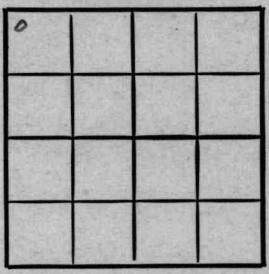

330 Ft. from N. Line

_____ Ft. from S. Line

_____ Ft. from E. Line

330 Ft. from W. Line

Ellis County

Location _____

Rig up _____

Drilling and Remarks:

Lane 3454

Cir +3917.

RECORD

Cased _____ in., _____ ft.

Sand _____

Gas _____

Oil _____

Total Depth 3945

PRODUCTION

1st 24 hrs. Nat. _____

1st 24 hrs. after shot _____

Gas _____ Cu. Ft.

Dry Hole _____

Abandoned _____

Date

DEC 28 1949 19

S. J. LEWIS Scout

FORM 275 FOR SALE BY KANSAS BLUE PRINT CO.

County Ellis State Kansas

Sec. 36 (Blk. Twp.) 12 (Sur. Rge.) 20W Map No.

Operator Flynn Oil

Well No. 1 Farm Weisner

Elev. 2170 Location NW NW NW



330 Ft. From N Line NW

330 Ft. From W Line Quarter

1st. Report

Completion SEP 2 4 1952

Remarks OWWO O.W.W.O.

Aylward - Contr.

Spudding Date

Drlg. Data D & A TD 3947

Lans. 3494 Cnng. 3842 Simp. 3891

Arb. 3917 OTD 3947 5" @ 3915 D & A

CO 5" @ 3930 48/ 3882-90 S/ 10 boph

23/ 3882-90 FU 620' oil 3 hr.

24/ 3882-90 S/ 10½ bo 1 hr. S/ 4 bo

2nd hr. S/ 14 bo 3rd hr. 30/ 3863-68

18/ 3873-76 S/ 4.7 bo ½ bwph

P/ 14 bopd 60 bw 30/ 3858-63 dry

6/ 3879-80 wtr. 48/ 3872-80 sd/-frac

200 A 4 bwph 12 goph 24/ 3888-92

D & A

J. G. McGEHEE