

Trego


KANSAS

FORM 51

Section 2 Township 12 Range 21W

Well No. #1 Shaefer

Company Transit Corp.

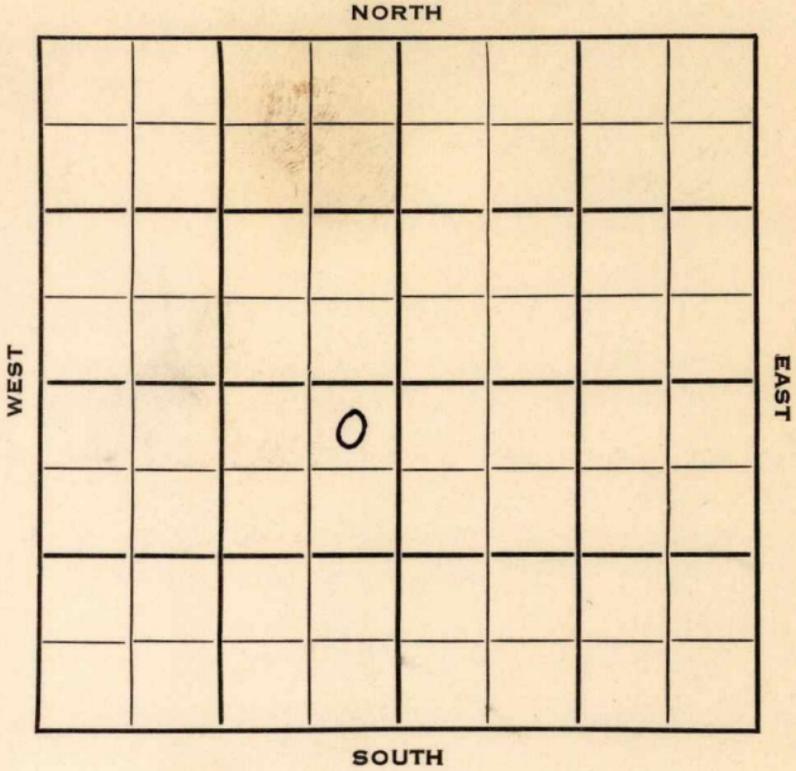

Sec. 2 Twp. 12 R. 21W

Well No. #1 Shaefer Farm

Transit Corp. Company

Transit Contractor

Wildcat

330 Ft. from N. Line


_____ Ft. from S. Line

330 Ft. from E. Line

_____ Ft. from W. Line

NE NE SW

Amerada - FO

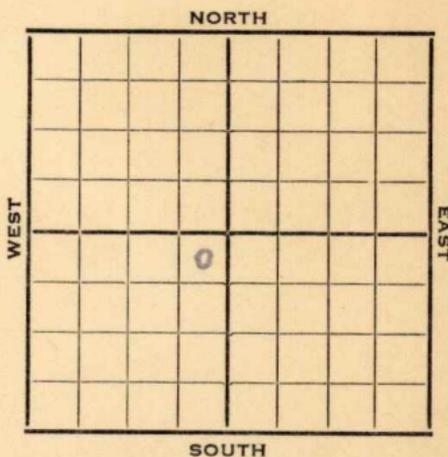

1953

Elev. 2311'

REPORT

7/14

Spud 7-9-53

8" @ 182

Anh 1740

Drlg. 2485'

7/22

Heeb 3585' Tor 3608' Lans 3622

DST 3746-3806, 1 hr, 30' M 160#

Marm 3923'

DST 3925-49, 1/2 hr, 30' M 1000#

Drlg.

7/29

Spud 7-9-53 D & A TD 4020

8" @ 182 Anhy 1740 Heeb 3585

Tor. 3608 Lans 3622

DST 3746-3806' open 1 hr rec 30' mud

160# Marm. 3923

DST 3925-49 open 1/2 hr. rec 30' mud

1000# Arb. 3956

DST 3959-73 open 1/2 hr rec 30' mud 30#

DST 3972-4020 open 1/2 hr rec 15' mud

100#

D & A

ABANDONED

County **Trego** State **Kansas**

Sec. **2** (Blk. **12** (Sur. **21W** Map No. (Twp. **12** (Rge. **21W**)

Operator **Transit Corp.**

Well No. **1** Farm **Shaefer**

Elev. Location **NE NE SW**

FIRST REPORT

o

330 Ft. From **N** Line **SW**

330 Ft. From **E** Line **Quarter**

1st. Report **JUL 14 1953**

Completion

Remarks **Amerada - FO**

Transit - Contr.

Spudding Date **7-9-53**

Drlg. Data **Wildcat**

8" @ 182 Anh 1740 Drlg. 2485

J. G. McGEHEE


County Trego State Kansas

Sec. 2 (Blk. 12) (Sur. 21W) (Twp.) (Rge.) Map No.

Operator Transit Corp.

Well No. 1 Farm Shaefer

Elev. 2311 Location NE NE SW

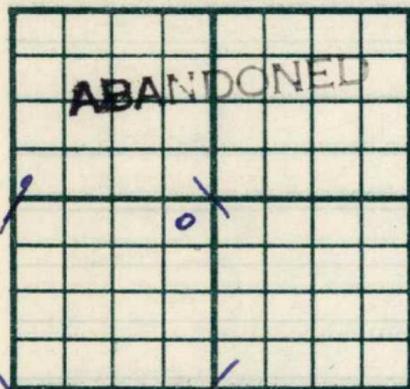

330 Ft. From N Line SW

330 Ft. From E Line Quarter

1st. Report

Completion JUL 29 1953

Remarks Wildcat

Transit - Contr.

Spudding Date 7-9-53

Drig. Data D & A TD 4020

8" @ 182 Anhy 1740 Heeb. 3585

Tor. 3608 Lens. 3622 DST 3746- 3806

open 1 hr. Rec. 30' mud 160#

Marm. 3923 DST 3925-49 open 1/2 hr.

Rec. 30' mud 1000# Arb. 3956

DST 3959-73 open 1/2 hr. Rec. 30' mud

30# DST 3972-4020 open 1/2 hr. Rec.

15' mud 100#

D & A