

O.W.W.O.


Barton

KANSAS

SECTION 6 TOWNSHIP 17S RANGE 11W

WELL NO. #1 M. Demel

COMPANY Engr. Construct. Co.

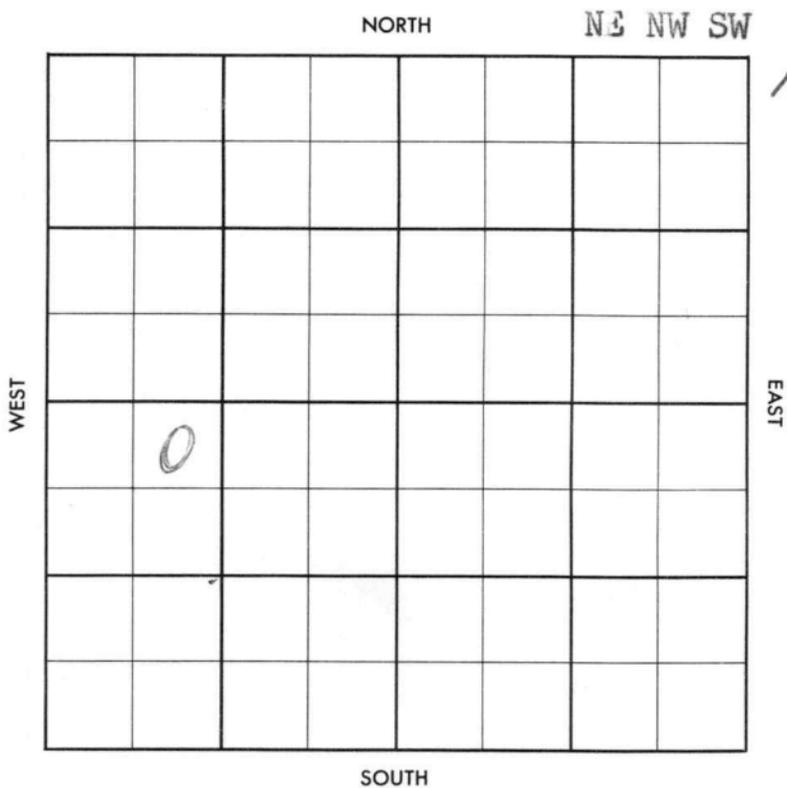

County Barton Elev. 1865 DF
 Sec. 6 Twp. 17S Rge. 11W
 Company Engr. Construct. Co.
 Farm Name M. Demel No. 1

TOPS	DEPTH	LOG	DATUM
Anh.			
TP.	2693		
H.	2933		
Tr.	2950		
Dg. <u>br. li.</u>	3031		
BL.			
L.	3046		
K.C.			
B.K.C.			
Ce.			
C.			
M.			
M.			
K.			
Mz.			
Mo.			
V.			
S.			
S.			
A	3303		
R.			
Pe.			
G.			
T.D.	3316		

Loc. in Sec. NE NW SW
 Geol. _____
 Contr. _____
 Peel Bros. Tools
 Pool
 Kraft-Prusa

COMPLETE	
d	
	OCT 21 '57

Date Comm. 9-3-57

8" @ 494, Drlg. 3040. SEP 12 '57 DST 3048
 -58 / hr @ 16" 1530' C GSSYO
 no water 7P 130 - 240 BHP
 1080 - 990/20 DST 3060-91
 1 hr @ 20" 25' @ 554 MSHO
 7P 115 BH 115-215/20
 215/20"
 DST 3198 - 3235 20" 30' M 50
 730/20 5 1/2" 3306 WOCT

Co.

Tools

No.

Sec.

T.

R.

SEP 25 '57

OCT 2 '57 CO 3316 SSO

200A No inc DD 3322

\$ 5 BOPh now P 80 B0

now 16 hrs

25 BOP d now

arbackle 3316-22

6-17-11W

me now sev

O.W.W.O.

~~18~~

S-513-B

County Barton Elev. 1862 DF
 Sec. 6- Twp. 17 Rge. 11W
 Company White Eagle (was Engr. Const. Co.)
 Farm Name Demel No. 1

TOPS	DEPTH	LOG	DATUM
Anh.			
Tp.			
H.			
Tr.			
Dg.			
B.L.			
L.			
K.C. <u>LKC</u>	<u>3046</u>		
B.K.C.			
Ce.			
C.			
M.			
M.			
K.			
Mz.			
Mq.			
V.			
S.			
S.			
A.	<u>3305</u>		
R.			
Pf.			
G.			
T.D. <u>ORTD</u>	<u>3316</u>		

Loc. in Sec. NE NW SW
(O.W.W.O.)
O.W.W.O.
 Geol. _____
 Contr. _____
 Pool _____
Demel

FIRST REPORT
 FEB 25 58

Date Comm. _____
OLD INFO: Was Arb well, P 25 BOPD no wtr. tops. 5" @ 3306, ORTD 3316.
NEW INFO: MICT & PB 18/3118-24 FU 700' oil/10", 8/3053-57 flo rate 20 BOPH, Flo 14 BOPH no wtr 24 hrs, WOP

Co. No. Sec. T. R.

O.W.W.O

2-213-B

On our old record of this well in the NE 1/4 NW SW, well #1 M. Demel, Engr.

Construction Co. Also on this ticket it says the old IP was P/15 BOPD + 15 BWPD ORTD 3322. On our old record the IP

was 25 BOPD, no Wtr. TD 3316.

Please check and advise.

Thanks,
Sam Baird

(O.W.W.O.)

O.W.W.O

FIRST REPORT
1958 28

Co. No. Sec. T. R.

Topo
Anr.
Tp.
Tr.
Dg.
B.L.
L.
K.C.
B.K.C.
Ce.
C.
M.
M.
K.
Mz.
Md.
V.
S.
S.
A.
R.
Pt.
G.

TOP2

3016

L.K.C.

3305

3316

TD ORTD

Date Comm.

OLD INFO: Was Arp well. P 25 BOPD no wtr. P

tops. 5" @ 3306, ORTD 3316.

NEW INFO: MICT & PB 18/318-24 BU 700'

011/10", 8/3053-57 flo rate 20 BOPD, flo

1A BOPD no wtr 24 hrs, WOP

O.W.W.O.

S-513-B

County Barton Elev. 1862 DF
 Sec. 6 Twp. 17 Rge. 11W
 Company White Eagle
 Farm Name Demel No. 1

TOPS	DEPTH	LOG	DATUM
Anh.			
Tp.			
H.			
Tr.			
Dg.			
B.L.			
L.			
K.C. <u>LKC</u>	<u>3046</u>		
B.K.C.			
Ce.			
C.			
M.			
M.			
K.			
Mz.			
Mq.			
V.			
S.			
S.			
A.	<u>3305</u>		
R.			
Pf.			
G.			
T.D. <u>ORTD</u>	<u>3322</u>		

Loc. in Sec. _____

NE NW SW

(O.W.W.O.)

Geol. O.W.W.O.

Contr. _____

Pool _____

Demel

COMPLETE

MAR 12 '58

Date Comm. _____

OLD INFO: Was Arb well, P 15 BOPD + 15 BWPD tops. 5" @ 3306, ORTD 3322.

NEW INFO: MICT & PB 18/3118-24 FU 700' oil/10", 8/3053-57 flo rate 20 BOPH, Flo 14 BOPH no wtr 24 hrs, WOP MAR 5 '58 F10
 25 Bopd NW thru csg MAR 12 '58 F10
 25 Bopd NW thru csg

Ls 3118-24
3053-57