

# KANSAS

Barton

FORM 51 5M 10-41 PETROL

Section 6 Township 17 Range 11-W

Well No. #1 Janssen "C"

Company Cities Service

NORTH Kraft Prusa Pool

							0

WEST

EAST

SOUTH

8

Sec. 6 Twp. 17 R. 11-W

Well No. #1 Janssen "C" Farm

Cities Service Company

(Kraft Prusa)


\_\_\_\_\_ Ft. from N. Line

990 Ft. from S. Line

330 Ft. from E. Line

\_\_\_\_\_ Ft. from W. Line

Elev. 1915

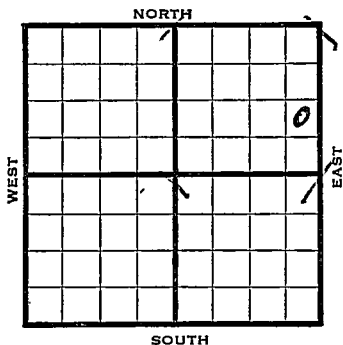

1942

REPORT

7/1 Location  
7/8 8" - 315' Drlg. 1360'  
7/15 Drlg. 3070'  
7/22 Arb. 3390'  
T.D. 3421'  
No shows.

ABANDONED

Map No. 55 Sec. 6 Twp. 17 R. 11W

Well No. 1 Janssen "C"

Cities Service Company

**FIRST REPORT** Contractor

NE SE NE


SECTION PLAT

           Ft. from N. Line

990 Ft. from S. Line

330 Ft. from E. Line

           Ft. from W. Line

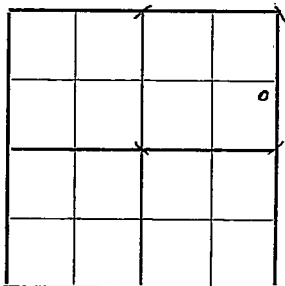

KRAFT PRUSA POOL

RECORD

Location                     XX

Rig up                     

Drilling and Remarks:



Cased            in.,            ft.

Sand                     

Gas                     

Oil                     

Total Depth                     

PRODUCTION

1st 24 hrs. Nat.                     

1st 24 hrs. after shot                     

Gas                      Cu. Ft.

Dry Hole                     

Abandoned                     

Date

JUL 1 1942

19

S. J. LEWIS

Scout

Map No. 53 Sec. 6 Twp. 17 R. 11W

Well No. 1 Janssen "G"

Cities Service Oil Company

**ABANDONED**

Contractor

SECTION PLAT

NE SE NE

\_\_\_\_\_ Ft. from N. Line

990 Ft. from S. Line

330 Ft. from E. Line

\_\_\_\_\_ Ft. from W. Line

			o

**KRAFT PRUSA POOL**

RECORD

Location \_\_\_\_\_

Cased \_\_\_\_\_ in., \_\_\_\_\_ ft.

Rig up \_\_\_\_\_

Sand \_\_\_\_\_

Drilling and Remarks:

Gas \_\_\_\_\_

Oil \_\_\_\_\_

*at 3390*

Total Depth 3421

*No shows.*

PRODUCTION

1st 24 hrs. Nat. \_\_\_\_\_

1st 24 hrs. after shot \_\_\_\_\_

Gas \_\_\_\_\_ Cu. Ft.

Dry Hole \_\_\_\_\_

Abandoned \_\_\_\_\_

Date

JUL 22 1942

19

S. J. LEWIS

Scout