


Section 6 Township 17 Range 11W

Well No. #1 Zorn

Company Lindsley

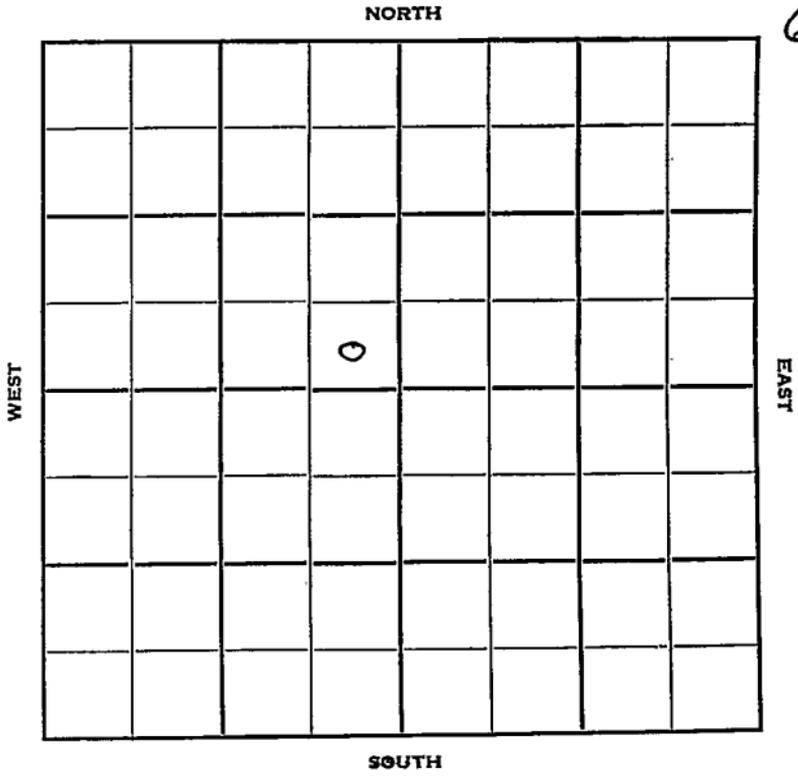

Sec. 6 Twp. 17 R. 11W ✓

Well No. #1 Zorn Farm

Lindsley Company

Wildcat Contractor


_____ Ft. from N. Line

330 Ft. from S. Line

330 Ft. from E. Line

_____ Ft. from W. Line

SE SE NW

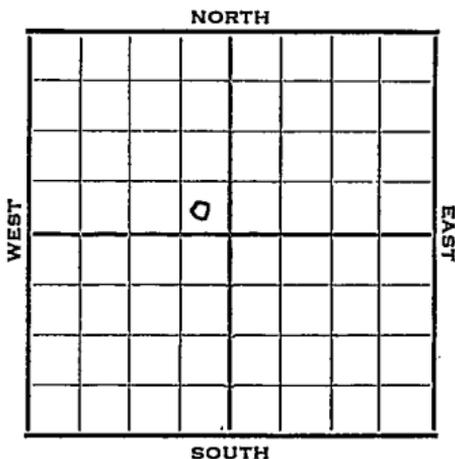

NCRA & Derby - DHM

1952 Elev. 1860' REPORT

5/14 8" @ 282'
Dr Ig. 2120'

5/20 Heeb 2936' Br li 3030' Lans. 3052'
Arb. 3322'
DST 3323-30 1 hr, 35' M O#
RTD 3334' 5" @ 3324'

5/28 DP 3334' 1000 A NO Rec. DD 3342' NS
DD 3352 TD wtr. to PB

6/4 D&A TD 3352 8" @ 282
Heeb. 2936 Br Lime 3030
Lans. 3052 Arb. 3322
DST 3323-30 opn 1 hr. Rec. 32' mud
TD 3334 5" @ 3324 DP to 3334
1000 A No inc. DD 3342
DD 3352 wtr PB 2998
32/2983-81 D&A

ABANDONED

