


Ellis

KANSAS

SECTION 34 TOWNSHIP 13 RANGE 20W

WELL NO. #3 J. Storm

COMPANY D.G. Hansen

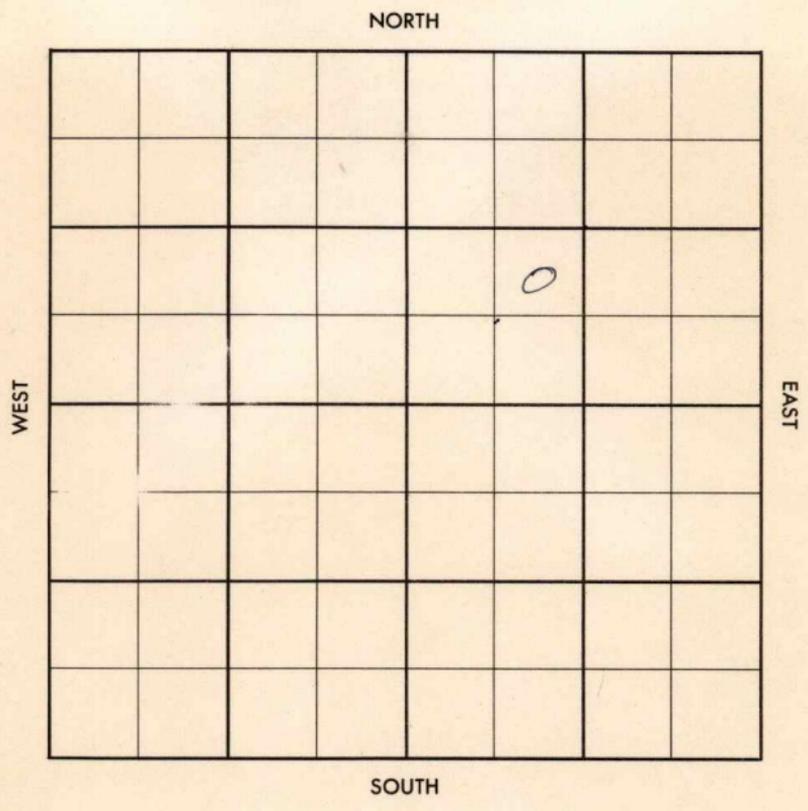

Ellis

KANSAS


SEC.	TWP.	R.
34	13	20W

WELL NO. #3 J. Storm FARM

COMPANY D. G. Hansen

CONTRACTOR Cook & Galloway Tools
Pleasant

_____ FT. FROM N. LINE
 _____ FT. FROM S. LINE
 _____ FT. FROM E. LINE
 850' _____ FT. FROM W. LINE

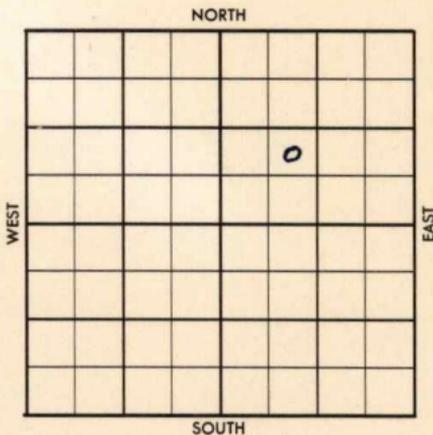

NE SW NE

1956	ELEVATION 2241 DF	REPORT
------	----------------------	--------

9-12
 Comm 9-7-56
 8" @ 269 w/170
 Ø 3160

County Ellis Elev. 2241 DF
 Sec. 34 Twp. 13 Rgs. 20W
 Company D.G. Hansen
 Farm Name J. Storm No. 3

TOPS	DEPTH	LOG	DATUM	Loc. in Sec.
Anh.				NE SW NE
Tp.				850 fwl
H.				
Tr.				
Dg.				
Bl.				
L.				Geol.
K.C.				Contr.
B.K.C.				Cook & Gallo way tools
Ce.				Pool
C.				Pleasant
M.				
M.				
K.				
Mz.				
Ma.				
V.				
S.				
S.				
A.				
R.				
Pe.				
G.				
T.D.				

SEP 12 1956
 0
 FIRST REPORT

Date Comm. 9/7/56
8" @ 269 w/ 170, Drlg. 3160

SEP 21 1956
 10:44 AM

[Large red handwritten mark]

County Ellis Elev. 2241 DF
 Sec. 34 Twp. 13 Rge. 20W
 Company D.G. Hansen
 Farm Name J. Storm No. 3

TOPS	DEPTH	LOG	DATUM	Loc. in Sec.
Anh.				NE SW NE
Tp.	3211			
H.	3465			850 fwl
Tr.	3486			
Dg.				
Bl.				
L.	3504			Geol.
K.C.				Contr.
B.K.C.	3757			Cook & Gallo way tools
Ce.				Pool
C. <u>Marin</u>	3768			Pleasant
M.				
M.				
K.				
Mz.				
Ma.				
V.				
S.				
A.	3827			
R.				
PE				
G.				
TD	3835			COMPLETE

Date Comm. 9/7/56

8" @ 269 w/ 170, Drif. 3160 SEP 19 '56

DST 3532-40 1hr rec 550'

oil + 460' OCM + 720' SW

BHP 1245 DST 3659-71 1hr

rec 30' Md BHP 1200

5 1/2 @ 3830/100 SEP 26 '56 ✓ WOCT

OCT 3 '56

OCT 10 '56

OCT 17 '56 XCO

3835 no tst Nm & app. 7 Boph

no water thru RVPump.

OCT 24 '56 OCT 31 '56

OCT 7 '56

on pump

Ph P. 80 Bopd + 390 wt.