

FORM 51 IOM 12-46 PETROL

46 PETROL KANSAS

Company Continental

Wildcat.

NORTH

WEST

EAST

SOUTH

KANSAS

Ellis



Sec. 35 Twp. 12 R. 20-W

Well No. 59 Strat (King) Farm

Continental Company

Wildcat


330 Ft. from N. Line

Ft. from S. Line

330 Ft. from E. Line

Ft. from W. Line

NE SW

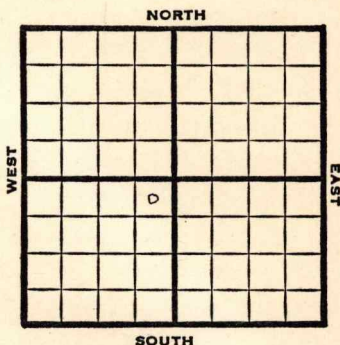

1947 **El. 2211'** REPORT

8/20 **Lans. 3524'**
Arb. 3884'
TD 3933
6" @ 3886'
RUST

8/27 "

9/3 500 acid w/9 bbls. oil 23 W 11 hrs.
2000 acid

9/0 W. PB

9/17 **Arb. 3884'**
6" @ 3886'
Total Depth 3933'

ABANDONED

Map No. _____ Sec. 35 Twp. 12 R. 2 OW

Well No. 59 Strat (King)

Continental

Company

FIRST REPORT

Contractor

NE SW


SECTION PLAT

330 Ft. from N. Line

_____ Ft. from S. Line

330 Ft. from E. Line

_____ Ft. from W. Line

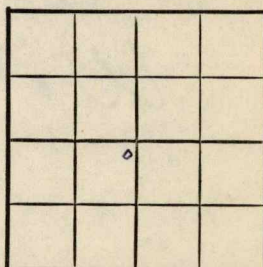

Ellis County

Location _____

Rig up _____

Drilling and Remarks:

Lans. 3524

Arb. 3884

TD 3933

6" @ 3886 RUST

RECORD

Cased _____ in., _____ ft.

Sand _____

Gas _____

Oil _____

Total Depth _____

PRODUCTION

1st 24 hrs. Nat. _____

1st 24 hrs. after shot _____

Gas _____ Cu. Ft.

Dry Hole _____

Abandoned _____

Date

AUG 20 1947

19

S. J. LEWIS

Scout

Map No. 70 Sec. 35 Twp. 12 R. 20W


Well No. 59 Strat (King)

Continental Company

ABANDONED Contractor

NE SW

E12211
SECTION PLAT

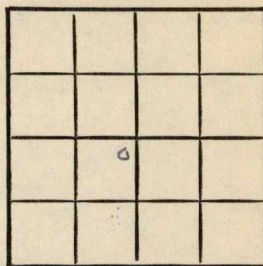

330 Ft. from N. Line

_____ Ft. from S. Line

330 Ft. from E. Line

_____ Ft. from W. Line

Ellis County

Location _____

Rig up _____

Drilling and Remarks:

Cr 8884
6 " @ 3876

RECORD

Cased _____ in., _____ ft.

Sand _____

Gas _____

Oil _____

Total Depth 8923

PRODUCTION

1st 24 hrs. Nat. _____

1st 24 hrs. after shot _____

Gas _____ Cu. Ft.

Dry Hole _____

Abandoned _____

Date

SEP 17 1947

19

S. J. LEWIS

Scout