

KANSAS Barton

Sec. 7 Twp. 17 R. 11W ✓

Well No. #1 Boor Farm _____
Aledo Oil Company _____

Wildcat


330' Ft. from N. Line

_____ Ft. from S. Line

_____ Ft. from E. Line

330' Ft. from W. Line

NW/C

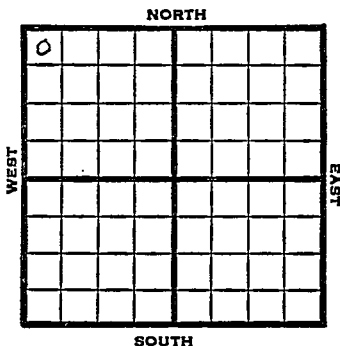

1949

Elev 1866' REPORT

3/30

Location

~~4/6~~

"

4/12

"

4/20

"

4/27

8" @ 225
Drlg 2203'

5/4

TD 3367'
Lans. 3056'
Arb. 3354'
Aband.

ABANDONED

Map No. _____ Sec. 7 Twp. 17 R. 11W

Well No. 1 Bohr

Aledo Oil Company

FIRST REPORT

Contractor

NW/C

SECTION PLAT

330 Ft. from N. Line

_____ Ft. from S. Line

_____ Ft. from E. Line

330 Ft. from W. Line

o			

Barton County

Location X

Rig up _____

Drilling and Remarks:

RECORD

Cased _____ in., _____ ft.

Sand _____

Gas _____

Oil _____

Total Depth _____

PRODUCTION

1st 24 hrs. Nat. _____

1st 24 hrs. after shot _____

Gas _____ Cu. Ft.

Dry Hole _____

Abandoned _____

Date

MAR 30 1949

19

S. J. LEWIS

Scout

Kansas

Map No. K 55 Sec. 7 Twp. 17 R. 11W

Well No. 1 Boor

Aledo Oil Company

ABANDONED

Contractor

NW/C

E. 1866
SECTION PLAT

330 Ft. from N. Line

_____ Ft. from S. Line

_____ Ft. from E. Line

330 Ft. from W. Line

4			

Barton County

Location _____

Rig up _____

Drilling and Remarks:

Have 3056

Oil 3354

RECORD

Cased _____ in., _____ ft.

Sand _____

Gas _____

Oil _____

Total Depth 3267

PRODUCTION

1st 24 hrs. Nat. _____

1st 24 hrs. after shot _____

Gas _____ Cu. Ft.

Dry Hole _____

Abandoned _____

Date

MAY 4 1949 19

S. J. LEWIS Scout