


Section 36 Township 12 Range 20W

Well No. #1 Orth

Company Musgrove Pet.

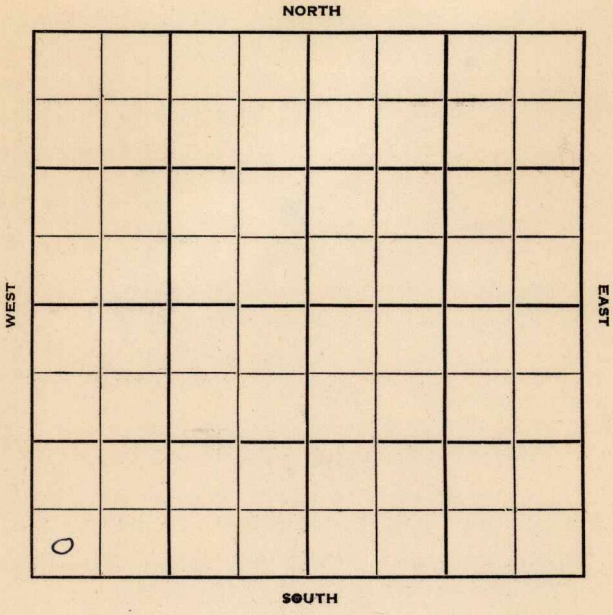

Ellis KANSAS

Sec. 36 Twp. 12 R. 20 W

Well No. # 1 Orth Farm

Musgrove Pet. Company

Musgrove Contractor
Wildcat


 Ft. from N. Line

330 Ft. from S. Line

 Ft. from E. Line

330 Ft. from W. Line

SW SW SW

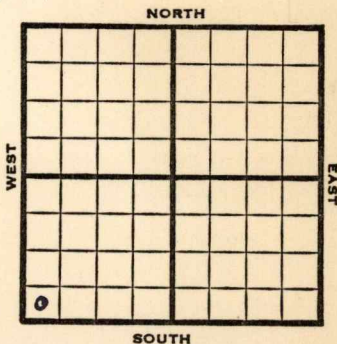

1952

Elev. 2158' REPORT

5/21

Spud 5-13-52
8" @ 192
Drlg. 3084'

5/28

Spud 5-13-52
D & A TD 3893' 8" @ 192
Top 3211' Heeb 3446' Tor. 3468'
Lans. 3485'
DST 3561-73 open 1 hr. rec 58' muddy
water SO
Cong. 3819' Arb. 3885'
TD 3893' D & A

ABANDONED

