


Section 14 Township 12 Range 21 W

Well No. #1 Baugher

Company R. W. Shields

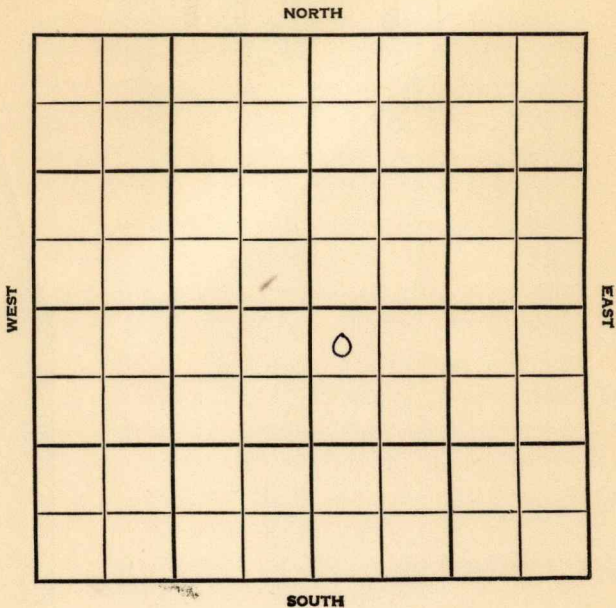

Trego

MINNDS

SEC.	TWP.	R.
14	12	21W

WELL NO. #1 Baugher FARM

COMPANY R. W. Shields

CONTRACTOR Glen Peel


Cotton

_____ Ft. from N. Line

_____ Ft. from S. Line

_____ Ft. from E. Line

_____ Ft. from W. Line

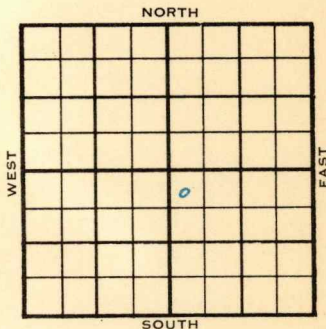

NW NW SE

Phillips DHM

Continental FO

	ELEVATION	REPORT
1955	2320'	
7/27	Comm 7-24-55 8" @ 214/150 Drlg 1725	
8/10	Comm 7-24-55 H 3575 Tr L 3609 A rework 3940	3579 3604 3616
Arb	x 3997	3996
	TD 4045 8" @ 214 w/150; DST 4000-11 op 25 min, rec 20' mud, vsoc, BHP 910# 20"	
	D & A	

ABANDONED

County Trego Elev. _____
 Sec. 14 Twp. 12 Rge. 21W
 Company R. W. Shields
 Farm Name Baughner No. 1

TOPS	DEPTH	LOG	DATUM	Loc. in Sec.
Anh.				NW NW SE
T.p.				
H.				
Tr.				
Dg.				
B.L.				
L.				
K.C.				Geol. _____
B.K.C.				Contr. _____
Ce.				<u>Glen Peel</u>
C.				
M.				Pool _____
M.				<u>Cotton</u>
K.				
Mz.				
Ma.				
V.				
S.				
S.				
A.				
R.				
Pe.				
G.				
T.D.				

FIRST REPORT
 0
 DEC 27 '55

Date Comm. 7-24-55 Phillips DEM
 Continental FO
8" @ 214/150 drlg. 1725

5

Co. Lse. No. Sec. T. R.

County Trego Elev. 2320
 Sec. 14 Twp. 12S Rge. 21W
 Company R. W. Shields
 Farm Name Baughner No. 1

TOPS	DEPTH	LOG	DATUM
Anh.			
TP.			
H.	<u>3575</u>	<u>3579</u>	<u>1259</u>
Tr.		<u>3604</u>	<u>1284</u>
Dg.			
BL.			
L.	<u>3609</u>	<u>3616</u>	<u>1296</u>
K.C.			
B.K.C.			
Ce.			
C.			
M.			
M.			
K.			
Mz.			
Mq.			
V.			
S.			
S.			
A <u>Rework</u>	<u>3940</u>		<u>1620</u>
R. <u>Arb</u>	<u>3997</u>	<u>3996</u>	<u>1676</u>
PE.			
G.			
T.D.	<u>4045</u>		

Loc. in Sec. _____
NW NW SE
 Geol. _____
 Contr. _____
Glen Peel
 Pool _____
Cotton

Phillips - DHM
 Contin. - FO
 AUG 10 1955
ABANDONED

Date Comm. 7-24-55; 8" 2 1/4 w/150; DST 4000-11
op. 25 min., rec. 20' mud, vsoc, BHP 910#
20"

D & A

Co.
 Lse.
 No.
 Sec.
 T.
 R.