

Hoodson

Form 51-5M-2-29-34703

Map No. KANSAS Sec.

7 Twp. 24 R. 14

Well No.


5-
Ocla

Dye
PWR

Farm

Company

NORTH

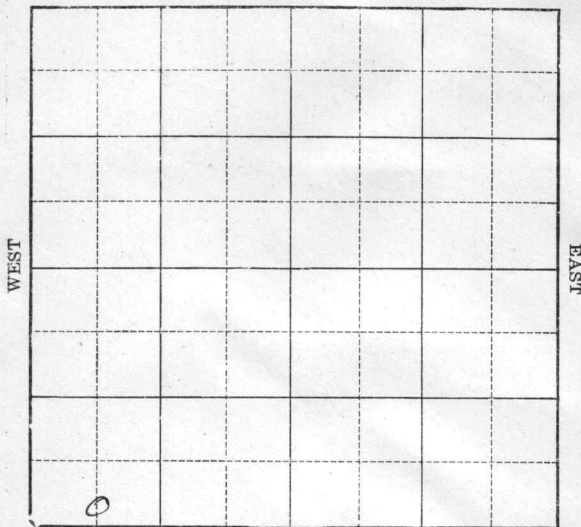

Location

Drilling Remarks

Rig Up

Drilling Remarks

RECORD

Cased in. ft.

Sand

Gas

Oil

Total Depth

PRODUCTION

1st 24 hrs. Nat.

1st 24 hrs. after shot

Gas cu. ft.

Dry Hole

Abandoned

Woodson

MAP No. *Kns* SEC. *7* TWP. *24* R. *14*

WELL No. *5* *Dye*

Oklahoma *P&R* COMPANY

CONTRACTOR

FIRST REPORTS
COMPLETED

SECTION PLAT

_____ FT. FROM N. LINE

_____ FT. FROM S. LINE

_____ FT. FROM E. LINE

_____ FT. FROM W. LINE

RECORD

LOCATION _____

CASED _____ IN. _____ FT.

RIG UP _____

SAND *1643-1658'*

DRILLING AND REMARKS:

GAS _____

50 Bls.

OIL _____

TOTAL DEPTH *1662'*

PRODUCTION

1ST 24 HRS. NAT. _____

1ST 24 HRS. AFTER SHOT _____

GAS _____ CU. FT.

DRY HOLE _____

ABANDONED _____

DATE

10/25/70

192

Shewood

SCOUT