7-24-14E

Sec. Twp. Rge.
Farm James Dye No. 5
O. P. & R. Company
Elev. T. D.
Log No.

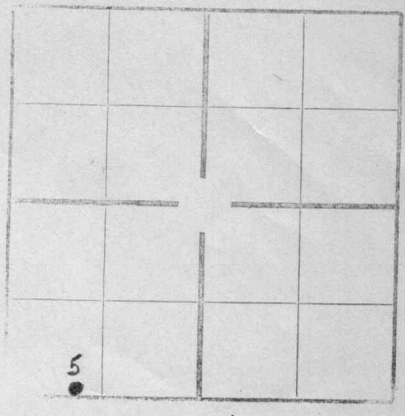

6835

WOODSON COUNTY KANSAS.

Drilling commenced Oct. 5, 1920.
Drilling completed Oct. 25, 1920.

Casing record: 12" 223'
10 759'
8¼" 1111'
6 5/8" 1608'

Soil	8
Sand	13
Gravel	18
Slate	37
W. Lime	47
B. shale	60
Lime	65
Slate B.	105
Lime white	120
Slate black	135
Lime white	155
Shale	213
Lime broken	223
Slate white	295
Lime grey	310
Lime broken	320
Slate	475
Lime white	517
Slate black	520
Lime white hard	700
Lime with water	725
Lime hard	753
Slate	758
Lime hard	765
Red rock	770
Blue shale	782
Lime	797
Sandy shale white	807
Lime white hard	885
Sandy shale blk	890
Lime white hard	905
Slate black soft	908
Lime white	935
Shale white	950
Water sand	990
Shale blk	1060
Lime gray hard	1065
Slate white	1080
Lime white	1090
W. Shale cave	1105
Lime white hard	1154
Slate gray	1180
Lime white	1195
Slate black	1205
Lime	1215
Slate white	1225
Lime	1245
Lime broken	1270
Slate white	1305
Lime gray	1315
Slate black soft	1370
Lime grey	1380
Slate black	1405
Slate white	1440
Slate black	1490
Lime gray	1496
Slate black	1510
Slate white	1540
Slate black	1545
Sandy sh le gray	1550
Slate blk	1605
Lime sandy	1643
Sand brown	1662
First oil showing at	1643
More oil at	1650
Bottom of hole	1662