


Section 10 Township 12 Range 21W

Well No. #1 Collins

Company Murfin Drlg.

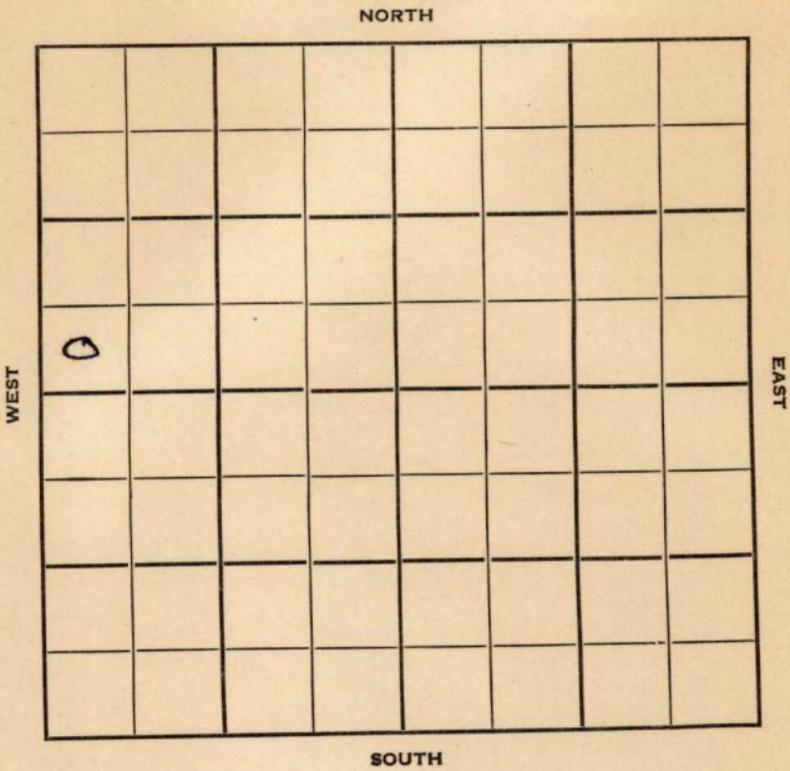

Trego

Sec. 10 Twp. 12 R. 21W

Well No. #1 Collins Farm

Murfin Drlg. Company

Murfin Drlg. Contractor


Wildcat

Ft. from N. Line

330 Ft. from S. Line

Ft. from E. Line

330 Ft. from W. Line  
SW SW NW

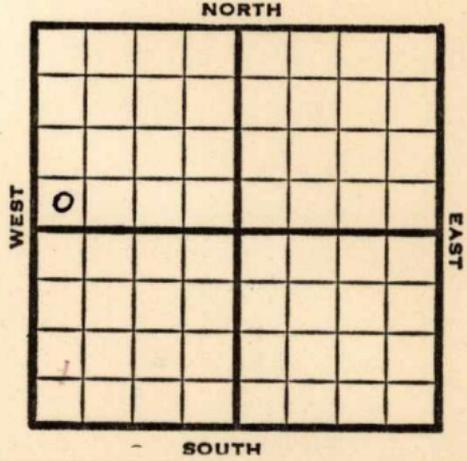

1952

Elev. 2341' REPORT

10/1

Location

10/8

8" @ 185, WOC

10/15

Heeb 3611, Lans 3648  
Drlg. 3815'

10/22

Spud 10-5-52

D&A

TD 4100'

8" @ 185

Heeb 3611', Lans 3648', Marm 3954',  
Arb. 3989'

DST 4002-22' opn 1 hr., rec. 11'  
socm, 3' free oil 0# DST 4022-31,  
opn 1 hr., rec. 8' socm, 2' free oil,  
30# DST 4033-50, opn 1 hr., rec. 21'  
ocm, 1' free oil 90#

TD 4100

D&A

**ABANDONED**



County Trego State Kansas

Sec. 10 (Blk. Twp.) 12 (Sur. Rge.) 21W Map No.

Operator Murfin Drlg.

Well No. 1 Farm Collins

Elev. 2341 Location SW SW NW


330 Ft. From S Line NW

330 Ft. From W Line Quarter

1st. Report

Completion OCT 22 1952

Remarks Wildcat

Murfin Drlg. - Contr.

Spudding Date 10-5-52

ABANDONED

Drlg. Data D & A TD 4100

8" @ 185 Heeb. 3611 Lans. 3648

Marm. 3954 Arb. 3989 DST 4002-22

open 1 hr. Rec. 11' socm 3' free oil

0# DST 4022-31 open 1 hr. Rec. 8'

socm 2' free oil. 30# DST 4033-50

open 1 hr. Rec. 21' ocm 1' free oil

90# TD 4100

D & A