

KANSAS

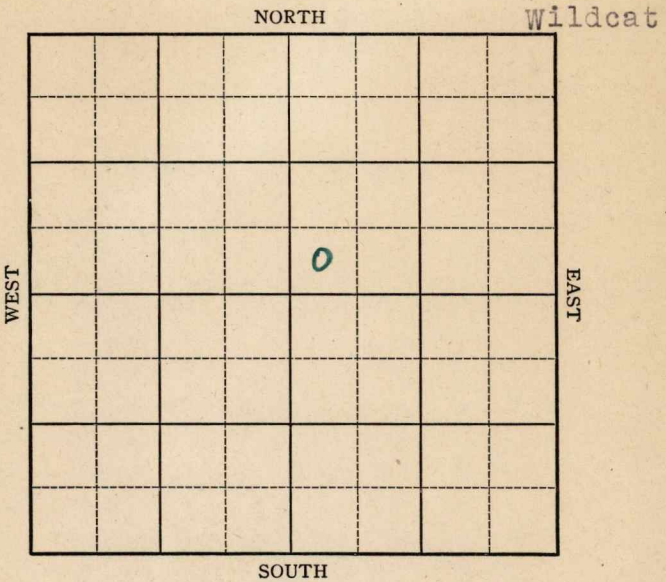
Trego

FORM 51 5M 4-41 PETROL

Section 10 Township 12 Range 21-W

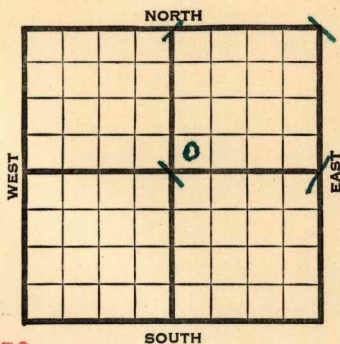
Well No. 1 Schaefer

Company Aylward & Barnett Drlg.



Sec. 10 Twp. 12 R. 21 -WWell No. #1 Schaefer FarmAylward & Barnett Drlg. Company

(Wildcat)

 Ft. from N. Line330 Ft. from S. Line Ft. from E. Line330 Ft. from W. Line

Elev. 2339

	REPORT
1941	
8/27	Derrick.
9/4	8" - 146' Drlg. 450'
9/11	Anhy 1765' Topeka 3384'
	Lans. 3626' Drlg. 3686'
9/18	B.K.C. 3854' Arb. 3984'
	T.D. 4007' 5" - 3985' RUST.
9/25	T.D. 4007' 2000 acid.
	Swab 4 oil in 8 hours.
10/2	Swab 10 oil in 8 hours.
10/9	" " " "
10/16	" " " "
10/23	T.D. 4005' SD.
10/30	P.B. to 3754'
	5 shots 3714-16' S.W.
	12 " 3710-14' 100' oil 12
	hours. P.B. to 3650'
	12 shots 3626 $\frac{1}{2}$ -34' 500 acid.
	400' oil 8 hours.
11/6	" " "
11/13	" " "
11/20	" " "
11/26	" " "

OVER

1941

12/4

P.B. to 3650'

12 shots 3626 $\frac{1}{2}$ -34' 500 acid.

Shut down.

12/10

Arb. 3984'

5" - 3985'

T.D. 4007'

3500 acid.

Pump 30 oil & 75 water.

35. Gravity

COMPLETED

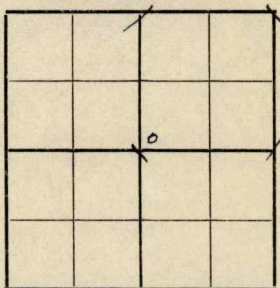
Map No. 70 Sec. 10 Twp. 12 R. 21WWell No. 1 Schaefer
Aylward & Barnett Drlg. Company

FIRST REPORT

Contractor

SW NE

SECTION PLAT

 Ft. from N. Line330 Ft. from S. Line Ft. from E. Line330 Ft. from W. Line

WILDCAT

Location Rig up

Drilling and Remarks:

Derrick

RECORD

Cased in., ft.Sand Gas Oil Total Depth

PRODUCTION

1st 24 hrs. Nat. 1st 24 hrs. after shot Gas Cu. Ft.Dry Hole Abandoned

Date

AUG 27 1941

19

S. J. LEWIS

Scout

Map No. 70 Sec. 10 Twp. 12 R. 21WWell No. 1 SchaeferAylward & Barnett Drilling CompanyCOMPLETED

Contractor

SW NE

104 SW 86
1 KG
Ft. from N. Line330 Ft. from S. Line

Ft. from E. Line

330 Ft. from W. Line

SECTION PLAT

WILDCAT

Location _____

Rig up _____

Drilling and Remarks:

CR # 89845" @ 89853500 acPump 30 in 175 Water35° Gr

RECORD

Cased _____ in., _____ ft.

Sand _____

Gas _____

Oil _____

Total Depth 4007

PRODUCTION

1st 24 hrs. Nat. _____

1st 24 hrs. after shot _____

Gas _____ Cu. Ft.

Dry Hole _____

Abandoned _____

Date

DEC 10 1941 19S. J. LEWIS Scout