


Section 11 Township 12 Range 21W

Well No. #1 Christopher

Company Davis Bros.

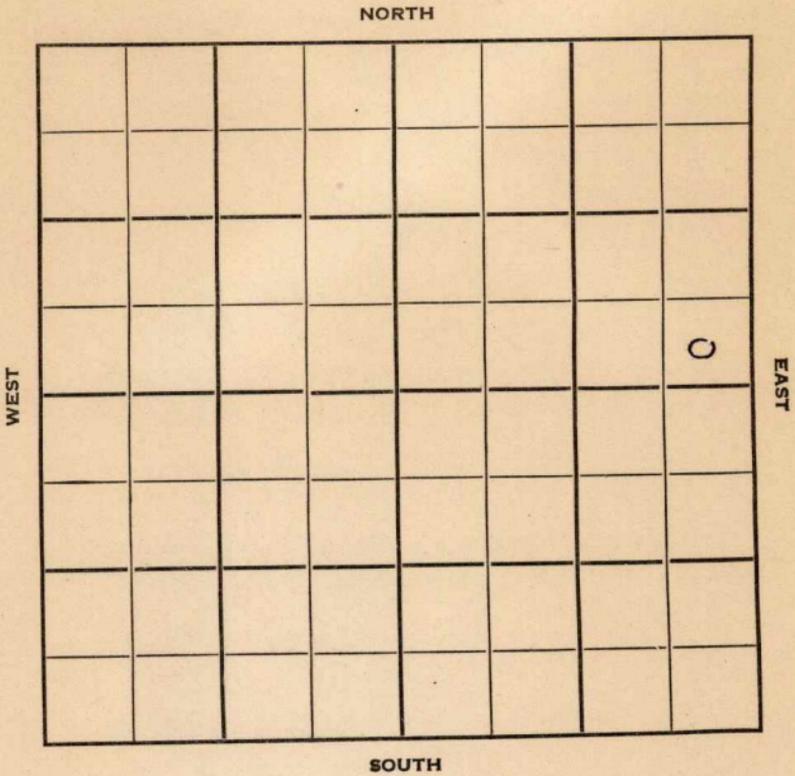

Trego

KANSAS

Sec. 11 Twp. 12 R. 21W

Well No. #1 Christopher Farm

Davis Bros. Company

Contractor

Wildcat


Ft. from N. Line

330' Ft. from S. Line

330' Ft. from E. Line

Ft. from W. Line

SE SE NE

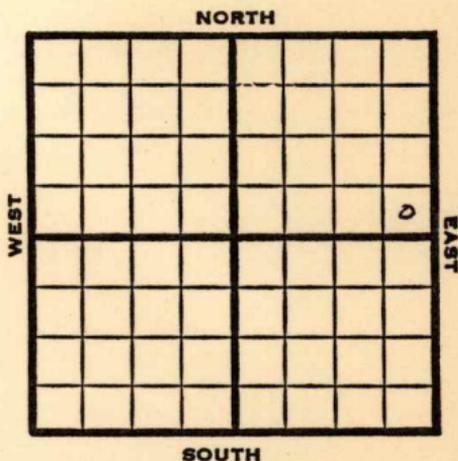

1951 Elev. 2331' REPORT

8/22 Spud 8-15-51  
8" @ 197  
Drlg. 3420'

8/29 Spud 8-15-51  
D&A TD 4066  
8" @ 197  
Top. 3408 Heeb. 3604  
KC 3636  
DST 3633-68 opn 1/2 hr  
Rec. 12' spotted ocm  
Arb. 4023-66 TD  
D&A

ABANDONED



County Trego State Kansas

Sec. 11 (Blk. 12) (Sur. Rge.) 21W Map No.

Operator Davis Bros.

Well No. 1 Farm Christopher

Elev. 2331 Location SE SE NE


**ABANDONED** 0

330 Ft. From S Line NE

330 Ft. From E Line Quarter

1st. Report

Completion AUG 29 1951

Remarks Wildcat

Spudding Date 8-15-51

Drlg. Data D & A TD 4066

8" @ 197 Top. 3408 Heeb. 3604

KC 3636 DST 3633-68 open 1/2 hr.

Rec. 12' spotted ocm Arb. 4023-66 TD

D & A

J. E. TYRA