


KANSAS

Trego

Section 11 Township 12 Range 21W

Well No. #1 Shaffer

Company Amerada Petroleum

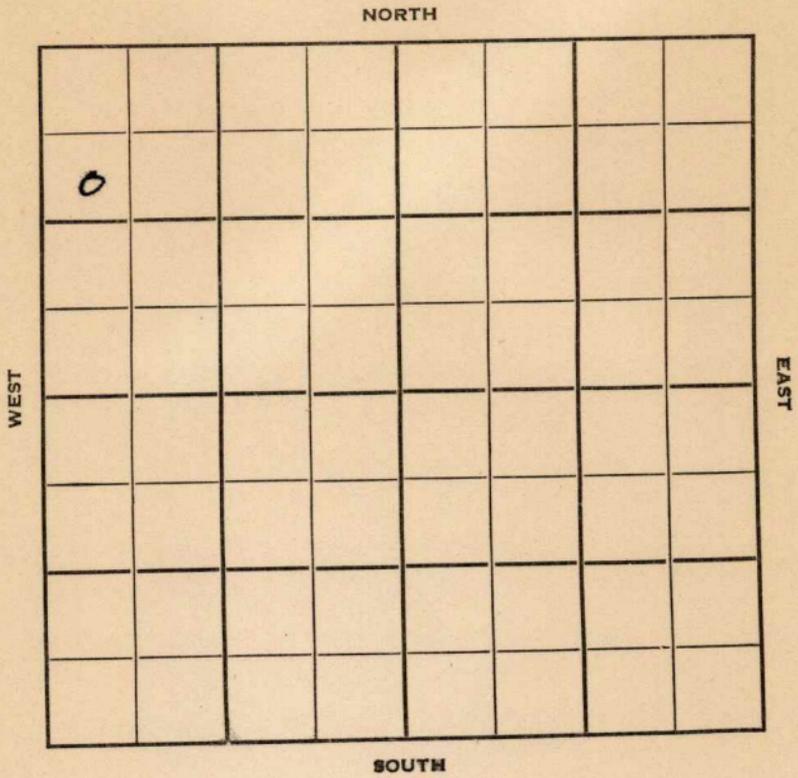



Sec. 11 Twp. 12 R. 21 W

Well No. # 1 Shaffer Farm _____

Amerada Pet. Company _____

Wildcat Contractor _____


990 Ft. from N. Line

_____ Ft. from S. Line

_____ Ft. from E. Line

330 Ft. from W. Line

SW NW NW

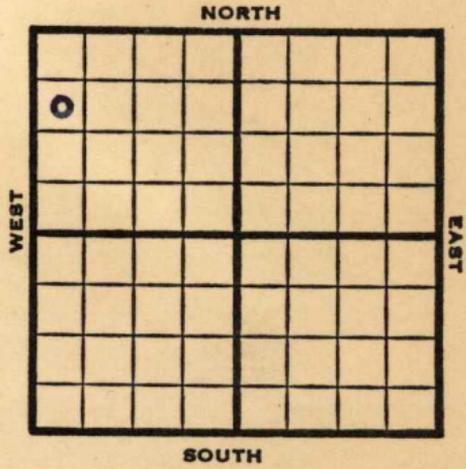

1953 **Elev. 2334'** REPORT

3/18 Spud 3-14-53
8" @ 212 **Anhy 1755**
Drlg. 1975'

3/26 Drlg. 3409'

4/1 Spud 3-14-53
D & A
TD 4022
8" @ 212
Anhy 1755, Top. 3405, Heeb 3600,
Tor 3618, Lans 3636, B KC 3874,
Marm 3929, Cong 3959,
DST 3631-44 open 1 hr. Rec 60' mud
1125#
Arb 3996,
DST 4003-22 open 1 1/4 hr Rec 80' so & wcm
800#
TD 4022'
D & A

ABANDONED


County Trego State Kansas

Sec. 11 (Blk.) 12 (Sur.) 21W Map No.

Operator Amerada Pet.

Well No. 1 Farm Shaffer

Elev. _____ Location SW NW NW

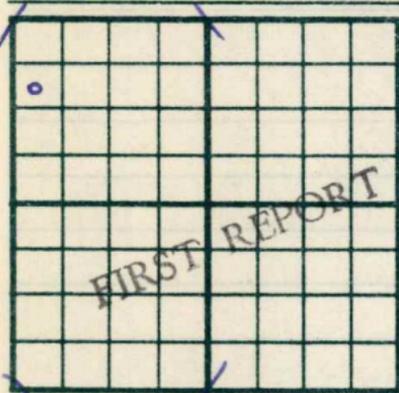

990 Ft. From N Line NW

330 Ft. From W Line Quarter

1st. Report MAR 18 1953

Completion _____

Remarks _____

Spudding Date 3-14-53

Drlg. Data Wildcat

8" @ 212 Anhy 1755 drlg. 1975

MAR 5 0 1953

