

Woodson


Form 51-5M-2-29-34703

Map No. KANSAS Sec. 7 Twp. 24 R. 14

Well No. 4 Farm Estes

Spencer & O'Sonnell Company

NORTH

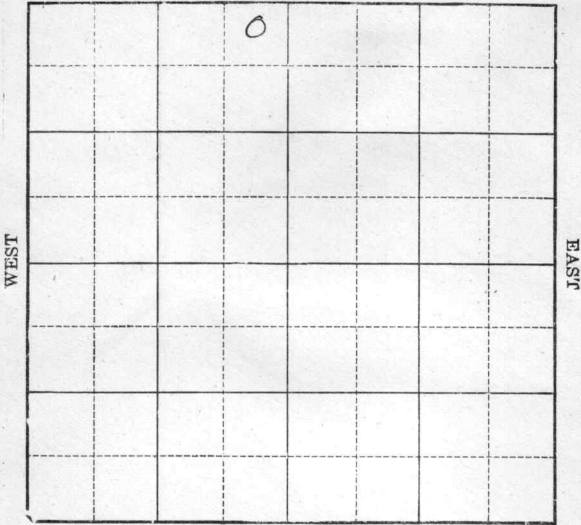

SOUTH

Location _____

Drilling Remarks _____

Rig Up _____

Drilling Remarks _____

RECORD

Cased _____ in. _____ ft.

Sand _____

Gas _____

Oil _____

Total Depth _____

PRODUCTION

1st 24 hrs. Nat. _____

1st 24 hrs. after shot _____

Gas _____ cu. ft.

Dry Hole _____

Abandoned _____

Woodson

MAP NO. Kns SEC. 7 TWP. 24 R. 14

WELL NO. 4 Ester

Spencer & O'Connell. COMPANY

CONTRACTOR

FIRST REPORTS
COMPLETED

SECTION PLAT

	0		

200 FT. FROM N. LINE

FT. FROM S. LINE

200 FT. FROM E. LINE

FT. FROM W. LINE

RECORD

LOCATION _____

CASED _____ IN. _____ FT.

RIG UP _____

SAND 1714-1729

DRILLING AND REMARKS:

GAS _____

top W 1691'

OIL _____

50 Bls

TOTAL DEPTH 1729

PRODUCTION

1ST 24 HRS. NAT. _____

1ST 24 HRS. AFTER SHOT _____

GAS _____ CU. FT.

DRY HOLE _____

ABANDONED _____

DATE

Sherwood