

Woodson

Map No.

KANSAS

Sec

7

Twp.

24

R.

14E


Well No.

9- Gate
Connolly & Cooper

Farm

Company

NORTH

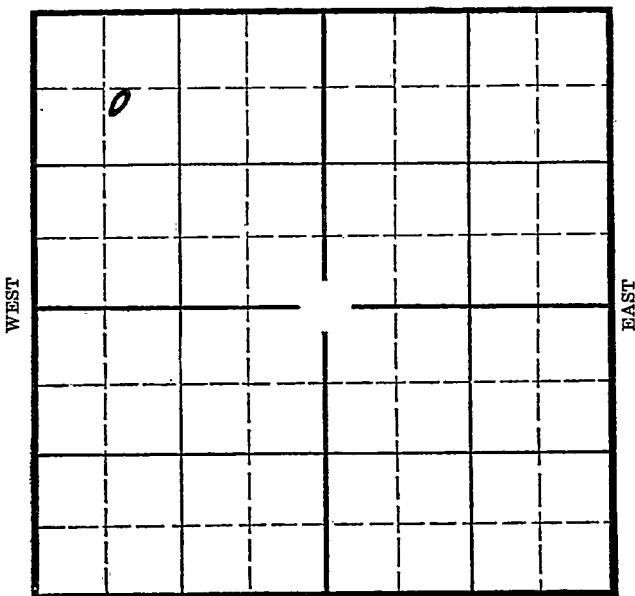

Location

Drilling Remarks

Rig Up

Drilling Remarks

RECORD

Cased _____ in. _____ ft.

Sand _____

Gas _____

Oil _____

Total Depth _____

PRODUCTION

1st 24 hrs. Nat. _____

1st 24 hrs. after shot _____

Gas _____ cu. ft. _____

Dry Hole _____

Abandoned _____

Woodrow

Map No. KANSAS Sec. 7 Twp. 24 R. 14E

Well No. 9-Ester Farm


Connolly & Cooper Company

750 Ft. from N. Line

_____ Ft. from S. Line

_____ Ft. from E. Line

750 Ft. from W. Line

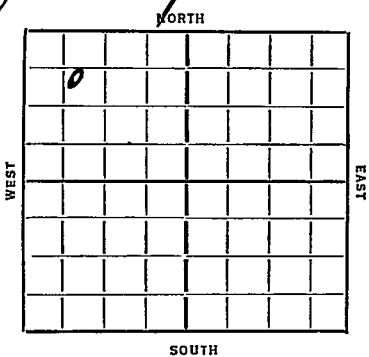

REPORT

1936
1/8

Top Well 1688

Pay 1712-30

TD 1731

pumped 15 Bbls Nat

Will acidize

1/15

TML 1688

TD 1731

1500 acid

50 Bbls

COMPLETED

Map No. 17 Sec. 7 Twp. 24 R. 14E

Well No. 9 - Ester

Connolly & Cooper Company

Contractor

SECTION PLAT

0			

750 Ft. from N. Line

..... Ft. from S. Line

..... Ft. from E. Line

750 Ft. from W. Line

FIRST REPORT

Location.....

Rig up.....

Drilling and Remarks:

*Top miss 1688
Pay 1712 - 30
TD 1731
Pumped 15 bbls net
Will acidize*

RECORD

Cased..... in., ft.

Sand.....

Gas.....

Oil.....

Total Depth.....

PRODUCTION

1st 24 hrs. Nat.....

1st 24 hrs. after shot.....

Gas..... Cu. Ft.

Dry Hole.....

Abandoned.....

Date

ORVAL MANNSCHRECK

JAN 8 1936 192

Scout

Map No. 17 Sec. 7 Twp. 24 R. 14EWell No. 9-EsterCornollet Cooper Company

Contractor

COMPLETE

SECTION PLAT

750 Ft. from N. Line

..... Ft. from S. Line

..... Ft. from E. Line

750 Ft. from W. Line

0			

Location.....

Rig up.....

Drilling and Remarks:

1500 and50 bbls

RECORD

Cased..... in., ft.

Sand TML 1688

Gas.....

Oil.....

Total Depth 1731

PRODUCTION

1st 24 hrs. Nat.....

1st 24 hrs. after shot.....

Gas..... Cu. Ft.

Dry Hole.....

Abandoned.....

Date

ORVAL MANNSCHRECK

1-15-36 192.....

Scout