

Theta Oil Company
A. J. Estes No. 6


Sec. 7, T. 24 S., R. 14 E.,
Woodson County, Kansas.

7-24-14E

Drilling Commenced: 6-26-22
Drilling Completed: 7-26-22

Casing Record:

10"	802'
8 1/4"	1140'
6 5/8"	1647'

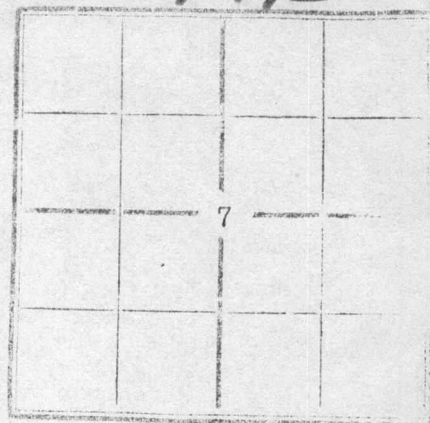

soil	3	
sand	15	
shale	35	
lime	55	
shale	85	
lime	115	
shale	140	
lime	170	
shale	200	Little gas
lime	260	
shale	280	3 Bailers water
lime	285	
shale blue	375	
shale brown	495	
lime white	510	
lime gray	525	
lime white	545	
slate	550	
lime white	650	
lime gray	705	
shale	720	
sand	755	Hole full water
lime	775	
shale	795	
red rock	802	
shale	835	
lime	855	
shale	885	
lime	905	
slate	920	
lime	930	
sand	940	4 Bailers water
shale	945	
lime	970	
shale	1000	
lime	1020	
shale	1090	
lime	1100	
shale	1120	
lime	1130	
shale	1140	
lime	1160	
shale	1200	
lime	1220	
shale	1275	
lime	1280	

shale	1400
lime	1420
shale	1500
sand	1580
shale	1647
lime	1679
sand oil	1693

Theta Oil Co. well #6
760' from W. line and
200' from S. line,
Sec. 7-24-14.

7-24-14E

Top Mississippi lime	1647 ft.
Top oil sand	1677 ft.
Bottom oil sand	1684 ft.
Total depth	1693 ft.

Shot with 50 qts. Good for 5 bbls.

1047
1122
575 ✓