

WH8-DC18 ✓

Trego

KANSAS

SECTION 20 TOWNSHIP 12S RANGE 21W

WELL NO. #1 Lang

COMPANY K & E Drlg.

				NORTH	NW NW SE			
WEST								
				SOUTH				
					EAST			

HOT FILE

Trego

KANSAS

SEC.

TWP.

R.

20

12 S

21 W

WELL NO.

1 Lang

FARM

COMPANY

K & E Drlg.
Charles-Seaney

CONTRACTOR


Wildcat

____ FT. FROM N. LINE

____ FT. FROM S. LINE

____ FT. FROM E. LINE

____ FT. FROM W. LINE

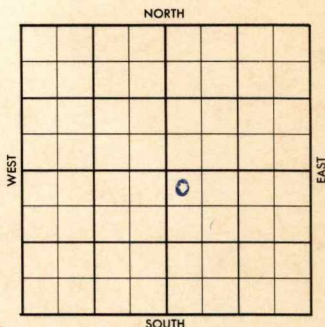

NW NW SE

NCRA-DHM

SDX-DHC-\$2500.00 (S-30544)

1958

ELEVATION

2258' DF

REPORT

(WH8-DC18)✓

6/6

To drill to a depth sufficient to
penetrate 50' into the Arbuckle
at appx 4000'

To be commenced by May 25, 1958

To be completed by June 25, 1958

(See copy DHC Agrt 6-6-58)

Location

(FR Tkt)

"

(WH Wkly Drlg. Rpt)

"

"

"

"

Spud 5-25-58

8-5/8" @ 220 w/150

Drlg. 2800'

"

DST 3590-3636', open 1 hr, rec 366'

MW. FP 28-235#. BHP 1355-1220# 20"

DST 3720-81', open 30", rec 12' mud.

FP 0# BHP 57# 20"

DST 3884-3910', open 1 hr, rec 155'

MW. FP 0-130#. BHP 1220-1115# 20"

Drlg. 3910'

Tops: Heeb 3532', Tor 3549', Lans
3566'

(WH Wkly Drlg. Rpt)

6/12

TD 4016' D & A

"

6/12

Spud 5-25-58 D & A 6-11-58

TD 4016' Log tops: Heeb. 3532', Tor.
3554' Lans. 3567', BKG 3806', Ft.

Scott 3880', C. 3920' Arb. 3979'

(Scout Completion ticket) **ABANDONED** ✓


WILDCAT

S-513-B

County Trego Elev. _____
Sec. 20 Twp. 12 Rge. 21W
Company K & E Drlg.
Farm Name Lang No. 1

TOPS	DEPTH	LOG	DATUM	Loc. in Sec. _____
Anh. _____				<u>NW NW SE</u>
Tp. _____				
H. _____				
Tr. _____				
Dg. _____				
B.L. _____				
L. _____				
K.C. _____				Geol. <u>WH 8-DC 18</u>
B.K.C. _____				Contr. _____
Ce. _____				
C. _____				
M. _____				
M. _____				Pool _____
K. _____				<u>Wildcat</u>
Mz. _____				
Mq. _____				
V. _____				
S. _____				
S. _____				
A. _____				
R. _____				
Pf. _____				
G. _____				
T.D. _____				

Date Comm. _____ NCRA - DHM
Location SDX-DHM

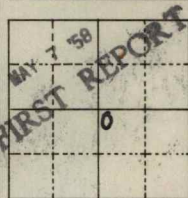

Co.

Lse.

No.

Sec.

T.

R.

MAY 9 1958
M. M.

Twps. ~~Pool~~
Co. ~~Facet~~

S-513-B

County Trego Elev. 2258 DF
Sec. 20 Twp. 12 Rge. 21W
K & E Drlg.
Lang No. 1

	DEPTH	LOG	DATUM
Anh.			
Tp.			
H.	3532	3532	
Tr.	3549	3554	
Dg.			
B.L.			
L.	3566	3567	
K.C.	DEC	3806	
B.K.C.	F+5 cat	3980	
Ce.			
C.		3920	
M.			
M.			
K.			
Mz.			
Mq.			
V.			
S.			
S.			
A.		3979	
R.			
Pf.			
G.			
T.D.	4016		

Loc. in Sec. NW NW SE

Geol.

Contr.

Pool

Wildcat

ABANDONED

JUN 11 '58

Date Comm. 5-25-58

NCRA - DHM

Location

SDX-DHM

MAY 14 '58 - MAY 21 '58 - MAY 28 '58 8" 220/150

Ø2400 JUN 3 '58 DST 3590 - 3636 1hr

366' MW FP 58-235 BHP 1355 -

1220/20" DST 3720 - 81 op 30" 12'M

FP 0 BHP 57/20" DST 3884 - 3910 1hr

155' MIN FP 0 - 130 BHP 1220 - 1115 1/20

Ø3910 JUN 11 '58 Stops TD 4016 Log tops

D6A

JUN 13 1958
M. M.