


Hoodson

Form 51-5M-11-31-Palace

Map No. **KANSAS** Sec. 7 Twp. 24 R. 14

Well No. 14 Dye Farm
Pure Oil Co Company

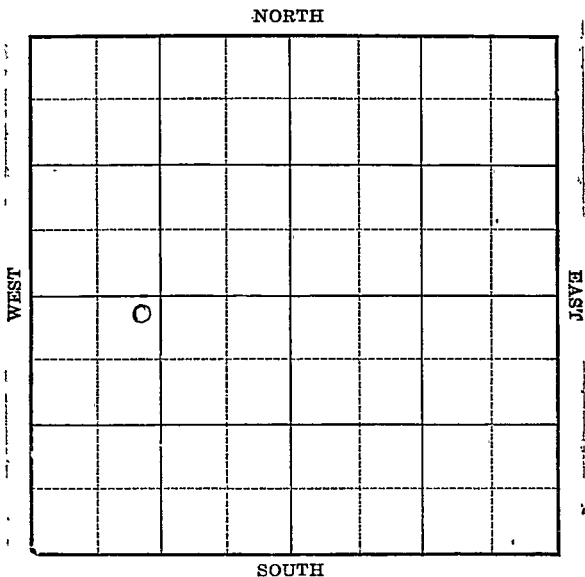

Location _____

Drilling Remarks _____

RECORD

Cased _____ in. _____ ft.

Sand _____

Gas _____

Oil _____

Total Depth _____

Rig Up _____

Drilling Remarks _____

PRODUCTION

1st 24 hrs. Nat. _____

1st 24 hrs. after shot _____

Gas _____ cu. ft.

Dry Hole _____

Abandoned _____

Woodson

Map No. KANSAS Sec. 7 Twp 24 R. 14⁶

Well No. 14 h/eye Farm _____


Pure Oil Co. Company _____

200' Ft. from N. Line

_____ Ft. from S. Line

_____ Ft. from E. Line

1160' Ft. from W. Line

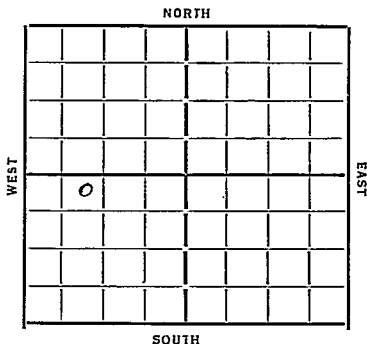

Date
1924

REPORT

1/10 Spud

1/17 drill 450

1/24 " 800

1/31 " 1075

2/7 " 1645

2/14 Line 1671 s.o. 1712-23

1000 gal acid No test

2/21 Line 1671 T.D. 1723 Oil

1712-23 25 Bbls.

COMPLETED

Map No. 17 Sec. 7 Twp. 24 R. 14E

Well No. 14-Dye

Pure Oil Co Company

Contractor

SECTION PLAT

FIRST REPORTS
200 Ft. from N. Line

..... Ft. from S. Line

..... Ft. from E. Line

1160 Ft. from W. Line

o			

Location.....

Rig up.....

Drilling and Remarks:

Handwritten signature

RECORD

Cased.....in.,ft.

Sand.....

Gas.....

Oil.....

Total Depth.....

PRODUCTION

1st 24 hrs. Nat.....

1st 24 hrs. after shot.....

Gas.....Cu. Ft.

Dry Hole.....

Abandoned.....

Date

1-10-34 192 O. Manschreck Scout

Map No. 17 Sec. 7 Twp. 24 R. 14 E

Well No. 14 - Eye

Pure Oil Company

Contractor

COMPLETED

SECTION PLAT

200 Ft. from N. Line

..... Ft. from S. Line

..... Ft. from E. Line

1160 Ft. from W. Line

0			

RECORD

Location.....

Cased..... in. ft.

Rig up.....

Sand lime 1671

Drilling and Remarks:

Gas.....

Oil.....

oil 1712-23

Total Depth 1723

PRODUCTION

25 bbl

1st 24 hrs. Nat.....

1st 24 hrs. after shot.....

Gas..... Cu. Ft.

Dry Hole.....

Abandoned.....

Date

2-21-1924 O. Munnich Scout