


Section 21 Township 12 Range 21 W

Well No. # 1 Baugher

Company LaFayette Oil & Schaffer Drlg.

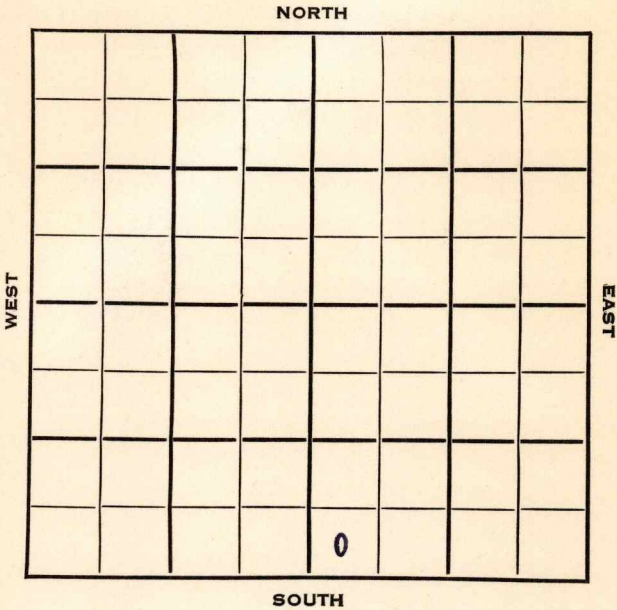

HOT FILE

Trego

KANSASSec. 21 Twp. 12 R. 21 WWell No. # 1 Baugher FarmLaFayette Oil & Schaffer Drlg. CompanySchaffer Drlg. Contractor

Wildcat

Ft. from N. Line

330

Ft. from S. Line


Ft. from E. Line

330

Ft. from W. Line

SW SW SE

MCPC has NW of 20-12S-21W

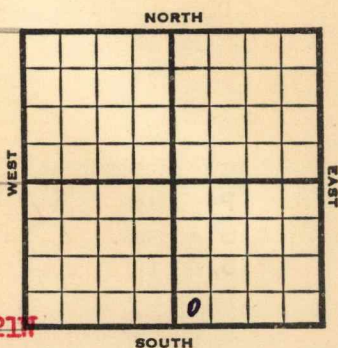

1953

Elev. 2249' REPORT

6/24

Spud 6-11-53

8" @ 262 anhy 1670' Heeb 3518'
KC 3550'DST 3581-3611 open 1 hr rec 60' HOCM
200' oil, 40' OCW 1075#DST 3634-47 open 1 hr rec 420' SW
1250#DST 3720-36 open 1 hr rec 8' SOCM O#
DST 3767-86 ?

7/2

Took DST 3767-87', open $\frac{1}{2}$ hr, rec 8'
mud. O# B KC 3794' Marm 3862'Took DST 3870-86, open 1 hr rec 90'
HOCM, 120' frothy oil, 60' free oil,
925# Cong 3898' Arb. 3933'

TD 3942' 5" @ 3936 RUST(Ltr-McGehee)

7/9

DD 3954' No test. PB 3890

20/3874-84 2 BOPH 12 hrs.

40/3879-84 S/2 BOPH sd-frac.

S/7 BOPH tubing & rods. (Ltr-McGehee)

7/23

Pumped 75 BO in 17 hrs. " "

7/30

State potential of 120 BOPD. " "

OVER

1953

7/29

Spud 6-11-53 Oil well TD 3942

8" @ 262 Anhy 1670 Heeb 3518

KC 3550

DST 3581-3611 open 1 hr rec 60' HOCM

200' oil, 40' OCW 1075#

DST 3634-47 open 1 hr rec 420' SW

1250#

DST 3720-36, open 1 hr rec 8' SOCM O#

DST 3767-86, open $\frac{1}{2}$ hr rec 8' mud O#

B KC 3794 Marm 3862

DST 3870-86 open 1 hr rec 90' HOCM

120' frothy oil, 60' free oil 925#

Cong 3898' Arb. 3933

TD 3942 5" @ 3936 DD 3954

PB 3890 20/3874-84 2 BOPH

sd-frac. 2 BOPH 12 hr. 40/3879-84

S/2 BOPH sd-frac. S/7 BOPH

P/75 BO 17 hr.

Comp. 120 BOPD

COMPLETED

FAST REPORT

Drilg. Data		Wildeat	
8" @ 262	Anhy 1670	Heeb.	3518
KC 3550	DST 3581-3611	open 1 hr.	
Rec. 60' hoom	200' oil	40' ocw	1075#
DST 3634-47	open 1 hr.	Rec. 420' sw	
1250#	DST 3720-36	open 1 hr.	
Rec. 8' socm	0#	DST 3767-86	

1947-1948

